
 STEPHEN PERRY SMITH ARCHITECTS 1100 N. VERLINDEN BLVD MILWAUKEE, WI 53211 PHONE: 414-224-1100 FACSIMILE: 414-224-1104		MARKUS HANCOCK GOOD HOPE COMMERCIAL CENTER MILWAUKEE, WISCONSIN		WILSON REALTY CO. OF WISCONSIN MILWAUKEE, WISCONSIN		SHEET NO. ADD	
PROJECT		DRAWING NO.		DATE		SCALE	
DRAWING NO.		DATE		SCALE		SHEET NO.	
PROJECT ALTERNATE		DRAWING NO.		DATE		SCALE	
PROJECT NUMBER		DATE		SCALE		SHEET NO.	
DATE		SCALE		SHEET NO.		SHEET NO.	

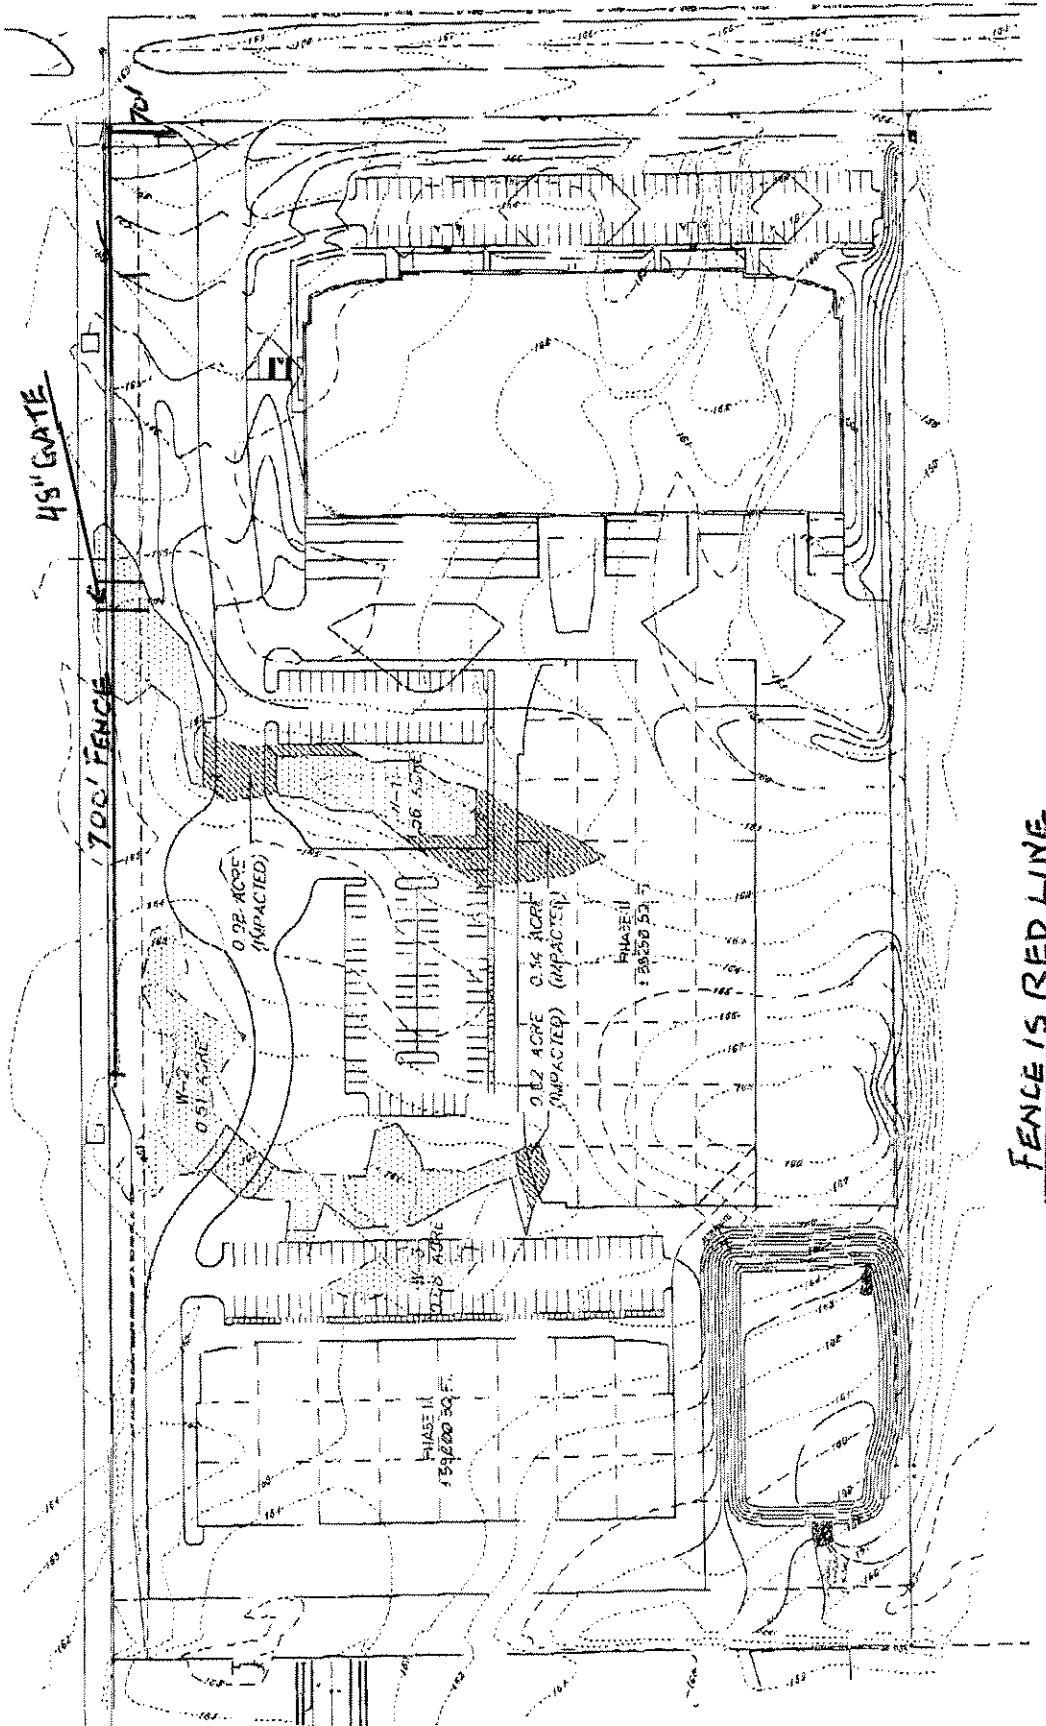

1 SITE PLAN
 SCALE: 1" = 100'-0"

FENCE IS RED LINE

EXHIBIT A
 FN 090262