



Air or Subterranean Space Lease Petition

809 N. Broadway, 1st Floor / Milwaukee, WI 53202-3617 / 414-286-8208

Submit this application with \$200 application fee to:
Milwaukee Development Center
Make check payable to City of Milwaukee.
Application fee is non-refundable.

~~9/15/21~~ Revision #1
10.08.21

Date 11/27/2021

TO THE HONORABLE, THE COMMON COUNCIL OF THE CITY OF MILWAUKEE:

The undersigned Wisconsin Center District

(state whether petitioner is an individual, co-partnership, Wisconsin or foreign corporation)

respectfully petitions the Common Council of the City of Milwaukee, according to the provisions of Section 66.048(3) and (4) of the Wisconsin Statutes, that the following space lease be granted:

Reference attached legal description for air rights at W. Wells St.

Air Space Lease for existing structure

of which building plans, plot plans and descriptive data showing the elevations, locations, height and size of the proposed structure and its relationship to adjoining buildings are herewith submitted.

The petitioners are the owners in fee of the following described real property:

400 W. Wisconsin Ave
Milwaukee, WI 53203

also known by street and number as 400 and W Wisconsin Ave
which property is located on both sides of that portion of the (street, alley or _____) to be so leased.

This petition is subject to such terms and conditions as may be agreed up on between the City of Milwaukee and the petitioner, which terms and conditions shall be set forth in a written lease pursuant to Section 66.048(3) and (4), Wisconsin Statutes. The leasing of such space shall be subject to a determination by the Common Council of the City of Milwaukee that such space is not needed for street, alley or other public purpose and that the public interest will be served by such leasing, and upon such determination as shall be authorized by ordinance duly passed by the City of Milwaukee.

Signature [Handwritten Signature]

Address 400 W Wisconsin

Phone (414) 908-6000

Corporation, firm or society WCD

Address _____

Title or office held in same _____

ATTACHMENT OF THE APPLICATION

TO: TECH TEAM, 809 N. BROADWAY, MILWAUKEE, WI 53202
FROM: DAN WEISS, CAA ICON
SUBJECT: WISCONSIN CENTER EXPANSION AIR RIGHTS - CONTACTS
DATE: ~~7/27/2021~~ **Revision #1 to City on 10.08.21**
CC: MIKE ABRAMS, CAA ICON; DAWN SCHMIDT, CITY OF MILWAUKEE

Contacts for the Wisconsin Center Expansion Air Rights:


Dan Weiss
CAA ICON (Owner's Representative)
414.345.0110
daniel.weiss@caaicon.com

Mike Abrams
CAA ICON (Owner's Representative)
303.210.7860
mike.abrams@caaicon.com

ALTA/ACSM LAND TITLE SURVEY



BEING IN THE SOUTHEAST ¼ OF THE NORTHWEST ¼ AND THE SOUTHWEST ¼ OF THE NORTHEAST ¼ OF SECTION 29,
TOWNSHIP 7 NORTH, RANGE 20 EAST, IN THE CITY OF MILWAUKEE, MILWAUKEE COUNTY, WISCONSIN.

Summary of easement on
following page

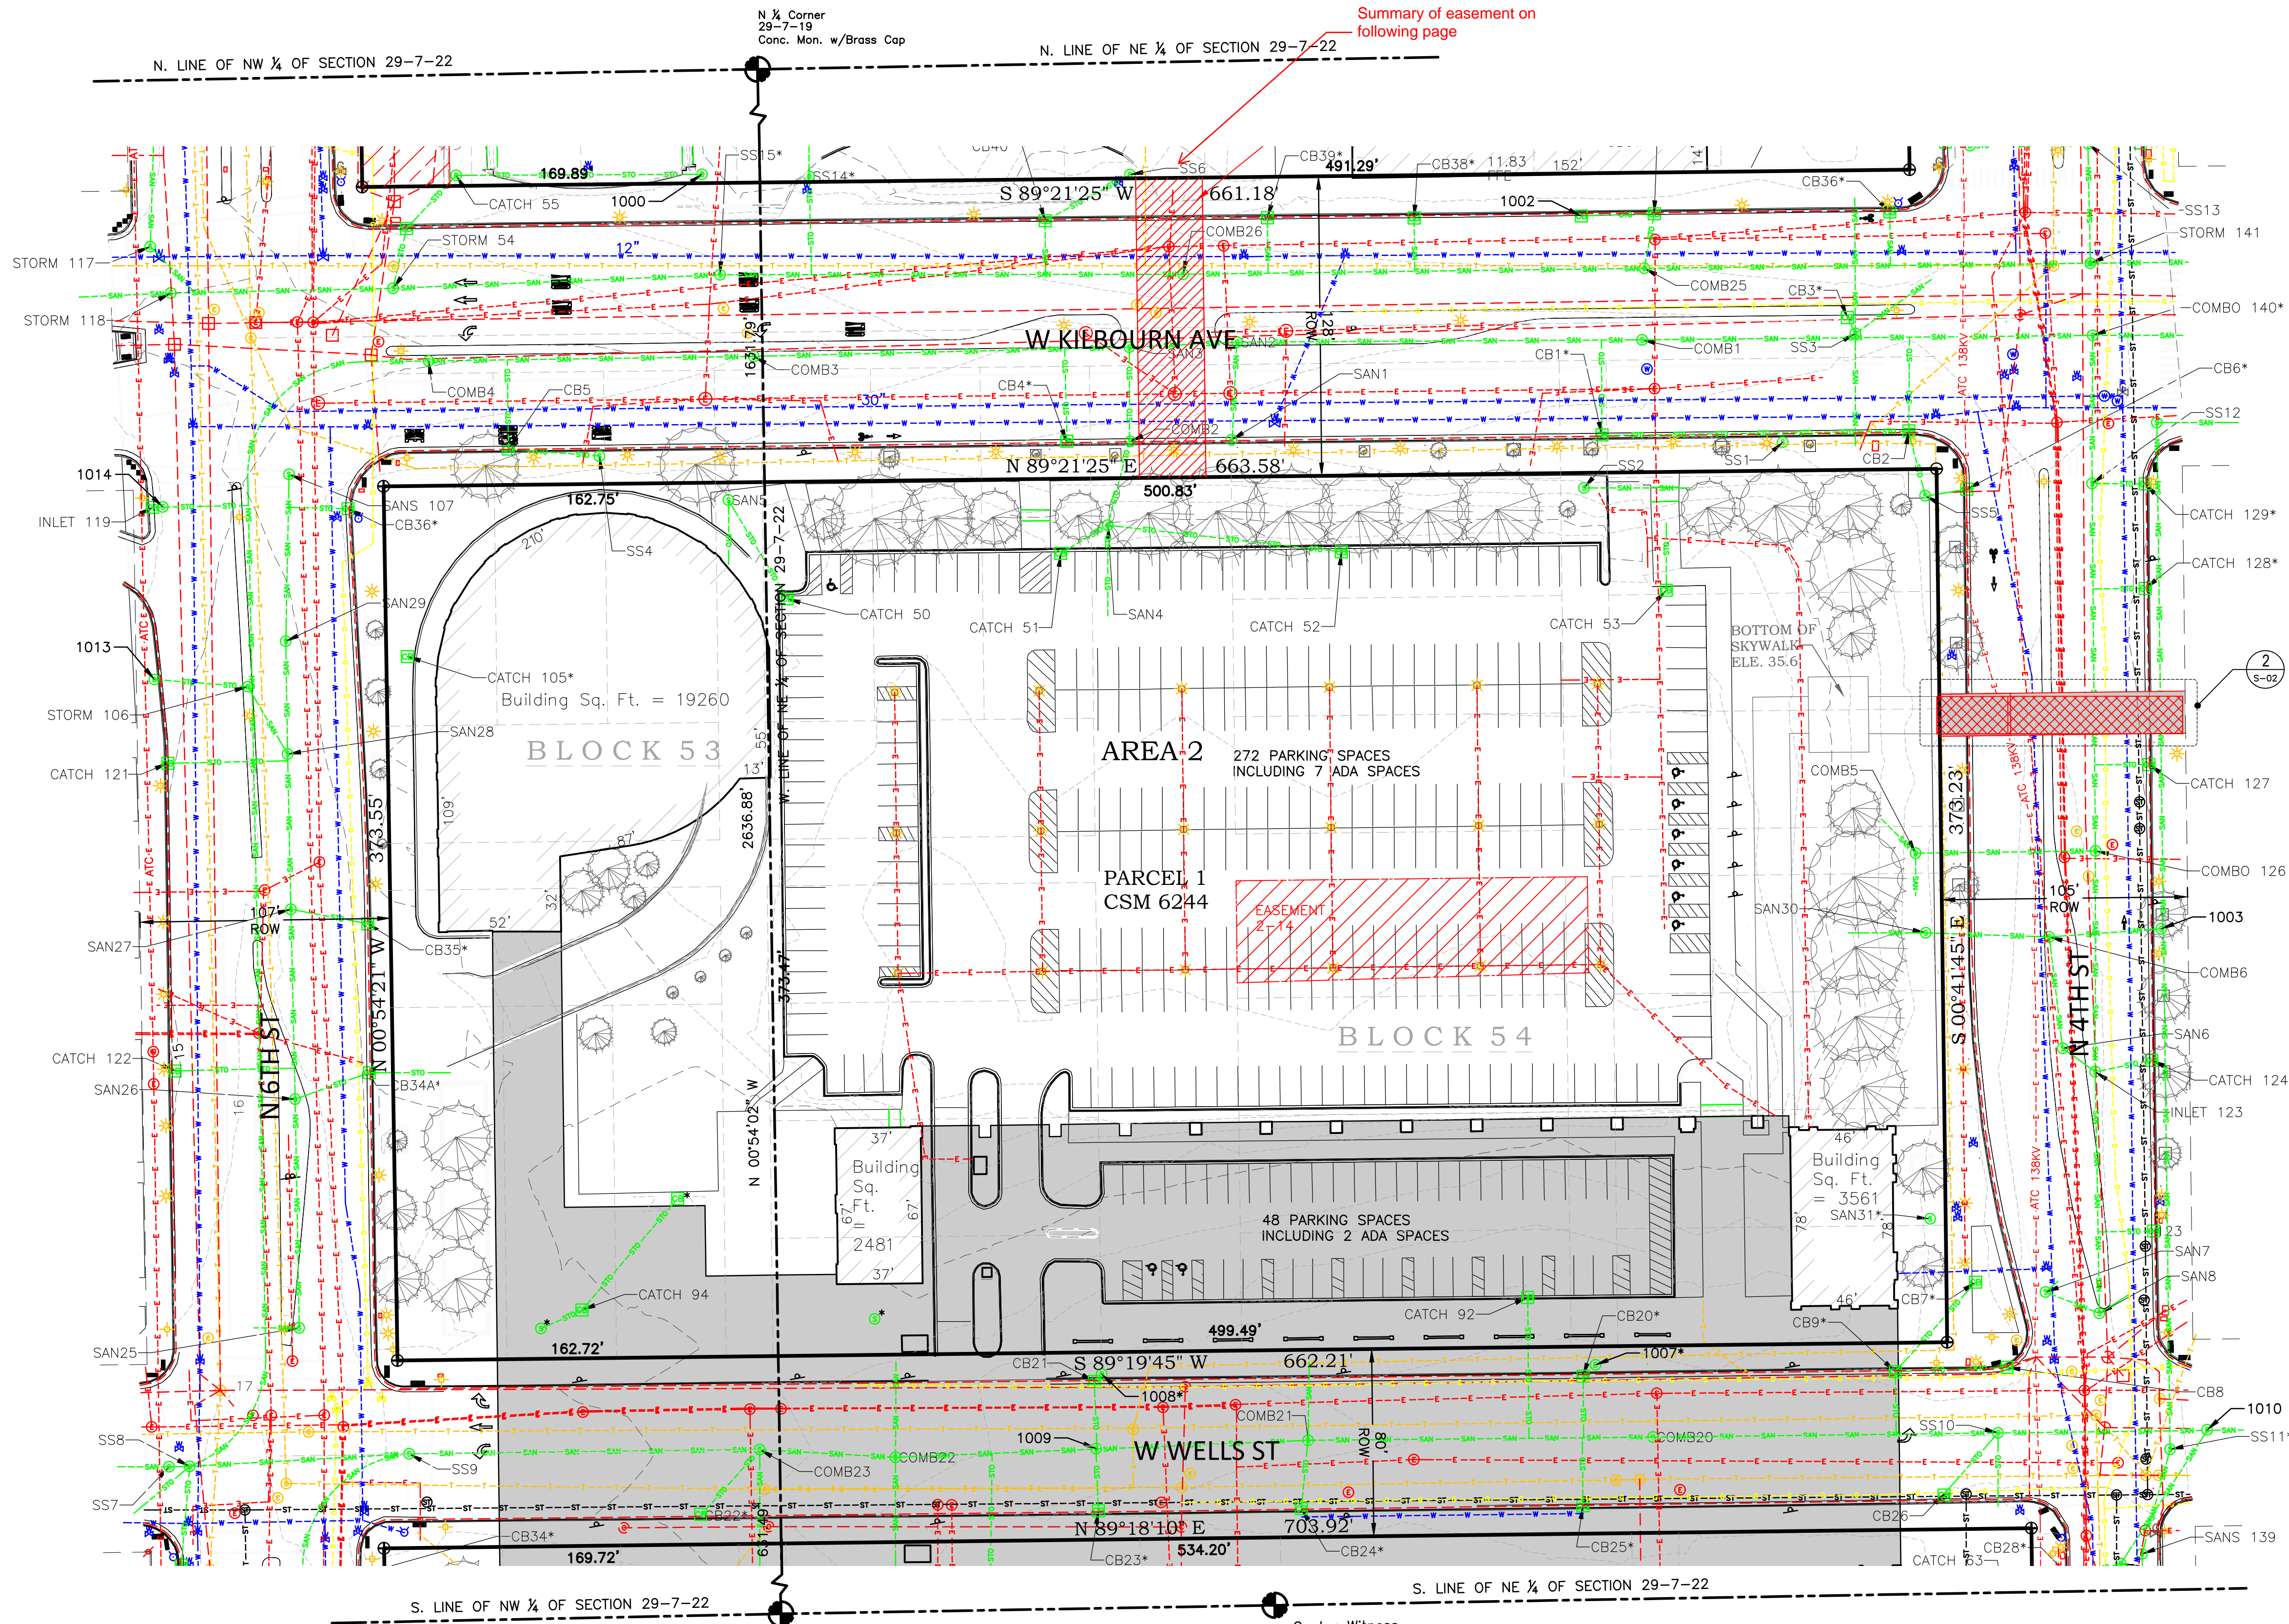

ALTA/ACSM AREA 2

SCALE: 1" = 40'

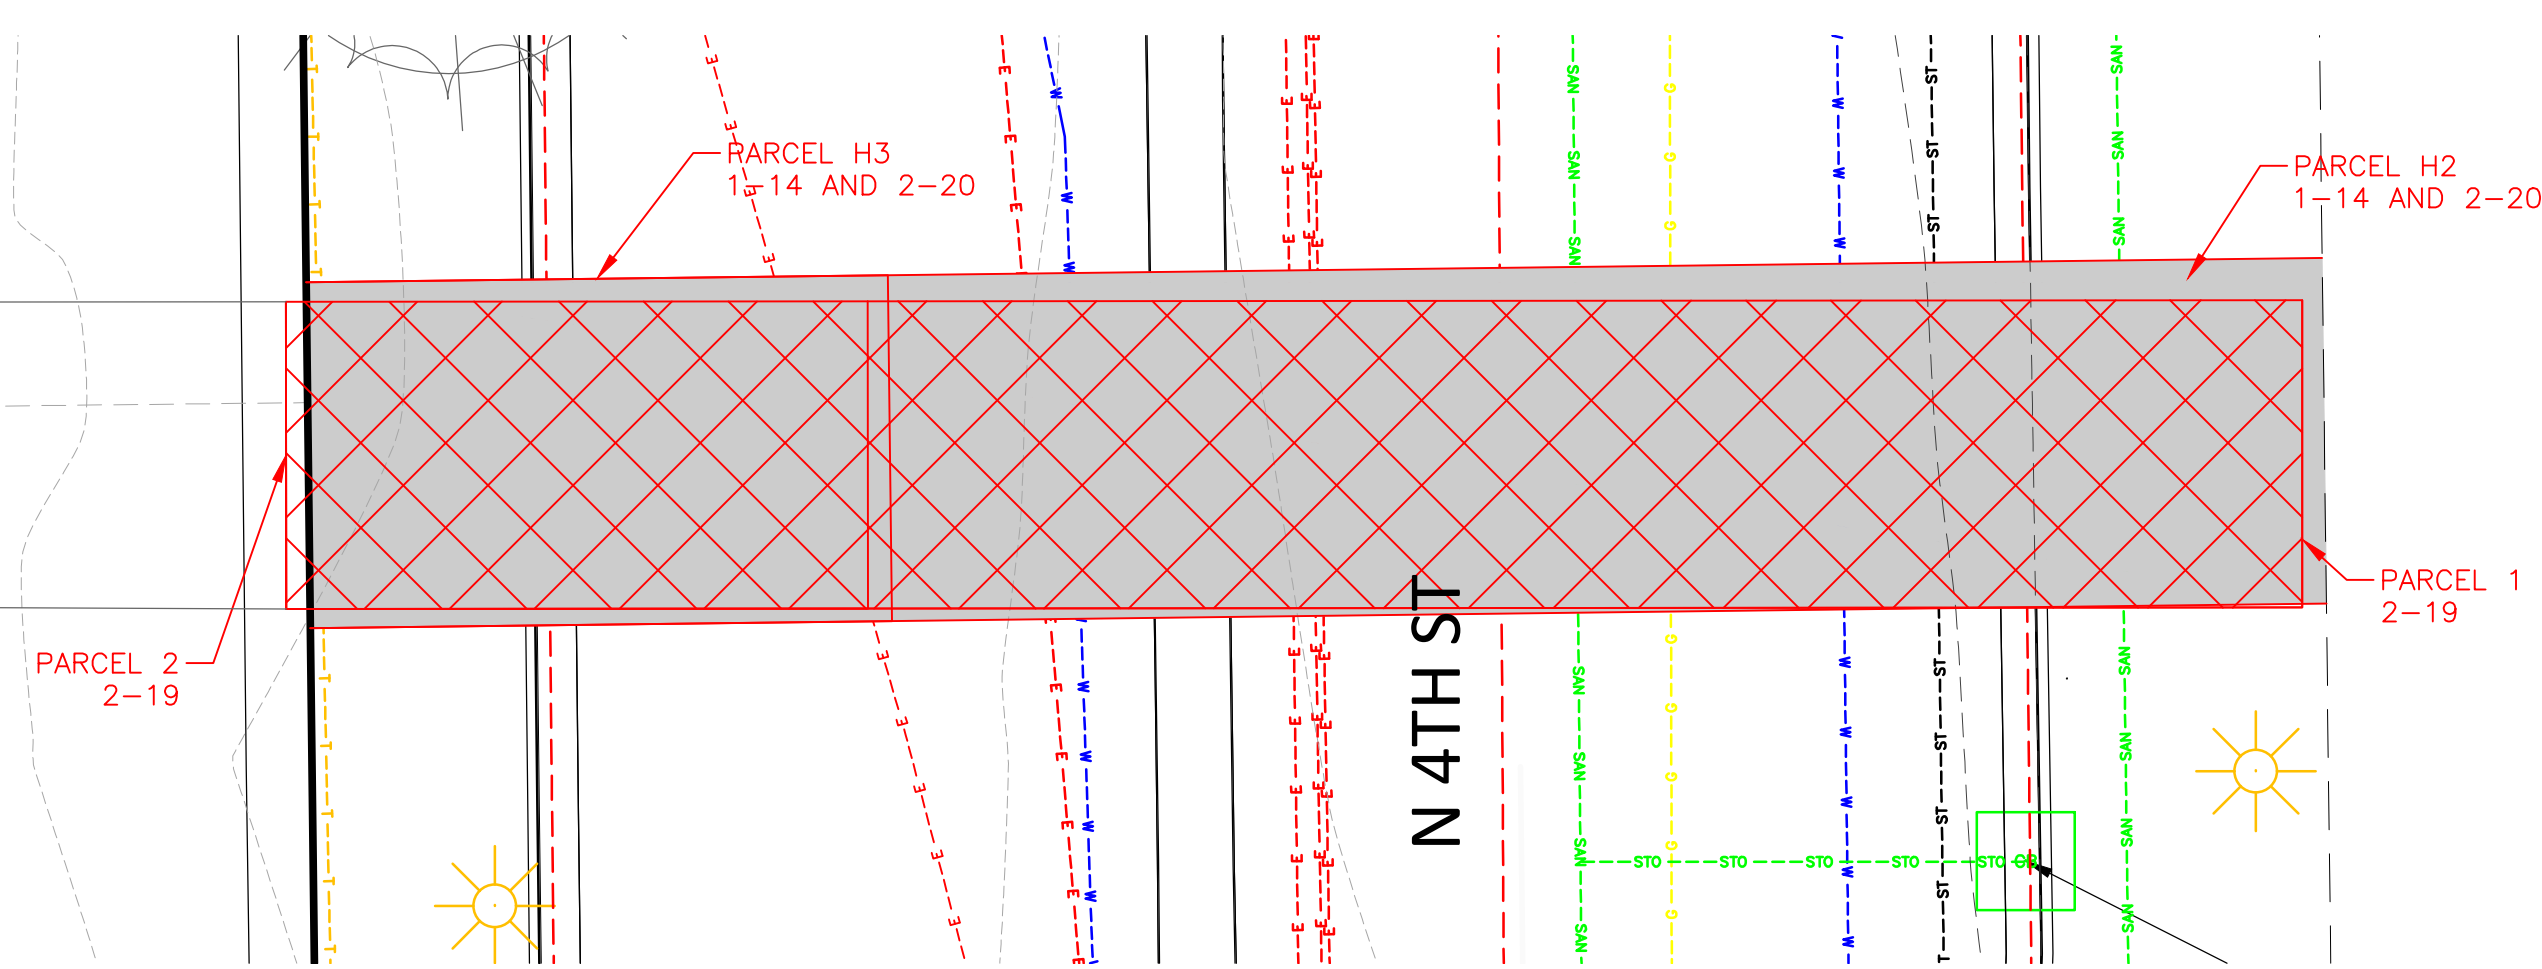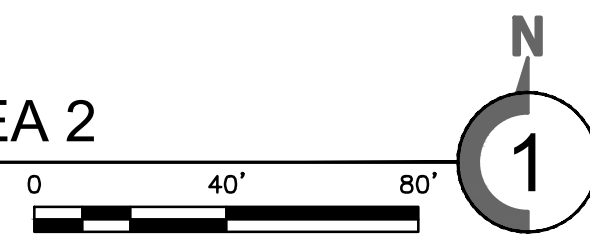

EASEMENT DETAIL

SCALE: 1" = 10'



DIGGERS HOTLINE:

DIGGERS HOTLINE PLANNING-LOCATE REQUESTS WERE PLACED ON 11/12/2019. MARKS AND FIELD EVIDENCE OF UTILITIES WERE LOCATED AND MAPPED 11/25/2019. FIELD LOCATIONS WERE COMPARED TO AS BUILT PLANS AND UNMARKED UTILITIES WERE ADDED WHEREVER POSSIBLE.

TICKET NUMBERS:
20194603779 - W. WISCONSIN AVE.
20194603820 - W. WELLS ST.
20194603850 - W. KILBOURN AVE.
20194603870 - W. STATE ST.
20194603905 - N. 6TH ST.
20194603925 - N. 4TH ST.

UTILITY DISCLAIMER:

THE LOCATION OF EXISTING UTILITIES AS SHOWN ON THE PLANS ARE APPROXIMATE. THERE MAY BE OTHER UTILITY INSTALLATIONS WITHIN THE PROJECT AREA THAT ARE NOT SHOWN. THE ENGINEER AND THE OWNER EXPRESSLY DISCLAIM ANY RESPONSIBILITY FOR THE ACCURACY OR COMPLETENESS OF THE INFORMATION GIVEN ON THE DRAWINGS WITH REGARD TO EXISTING UTILITIES.

BENCH MARK INFORMATION:

BM #1
HYDRANT AT THE SE CORNER OF 4TH ST. AND KILBOURN ST.
N. BOLT TOP FLANGE, ELEV.: 12.07

BM #2
HYDRANT AT THE SW CORNER OF 6TH ST. AND KILBOURN ST.
N. BOLT TOP FLANGE, ELEV.: 17.23


UTILITY PROVIDERS:

American Transmission	(262) 446-9821
AT&T Transmission	(800) 241-3624
MCI	(800) 289-3427
City of Milwaukee	(414) 286-3250
Milwaukee Metropolitan Sewerage District	(414) 617-6083
Windstream	(800) 289-1901
AT&T Distribution	(262) 446-9821
Time Warner Cable	(414) 228-5179
Uniti Fiber LLC	(262) 446-9821
WE Energies	(414) 563-0051
WE Energies	(414) 221-2290
State of Wisconsin Division of Facilities	(608) 266-1485
Level 3/ Centurylink	(877) 366-8344
Wisconsin DOT Southeast Region	(603) 288-9175
US Signal	(616) 430-7327

LEGEND:

- ⊕ - CHISELED X/T PROPERTY CORNERS SET
- - SANITARY SEWER MANHOLE
- - WATER MANHOLE
- ⊕ - WATER VALVE
- ⊕ - FIRE HYDRANT
- ⊕ - CATCH BASIN
- ⊕ - STORM SEWER MANHOLE
- ⊕ - ELECTRICAL MANHOLE
- ⊕ - BES FROM PLANS
- ⊕ - COMMUNICATIONS MANHOLE
- ⊕ - STEAM MANHOLE
- ⊕ - SIGN
- ⊕ - LIGHT
- ⊕ - POLE BOX
- ⊕ - UTILITY POLE
- ⊕ - GAS VALVE
- ⊕ - TRAFFIC LIGHT
- ⊕ - TREE (CONIFEROUS/DECIDUOUS)
- ⊕ - BES ELECTRICAL VAULT
- - SANITARY SEWER
- - WATER MAIN
- - STORM SEWER
- - STEAM UTILITY
- - ELECTRICAL UTILITY
- - TELECOMMUNICATIONS UTILITY
- - GAS UTILITY
- - WIND ELECTRICAL UTILITY
- - BES UTILITY
- - TRAFFIC LANE MARKING
- - PARKING LOT MARKING
- - BUILDING
- - OVERHEAD BUILDING

COLLINS ENGINEERS & SURVEYORS
203 West Howard Avenue
Milwaukee, WI 53233
Phone: 414-282-6955
Fax: 414-282-6955

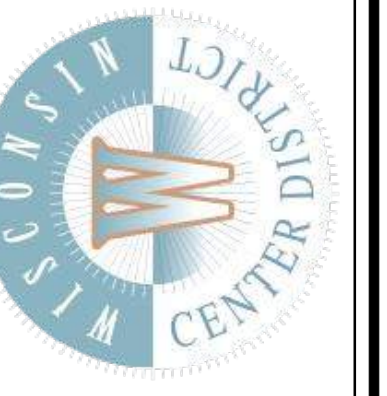

Area 2
ALTA/ACSM Land Title Survey
Wisconsin Center District

Milwaukee, WI

NO.	DATE	DESIGN BY	DESCRIPTION
1	2/07/2020	DLK	ALTA REVISIONS/138 KV LOCATION

CEI PROJECT: 60-12124

DESIGN BY: DLK

DRAWN BY: MDG


CHECKED BY: DLK

DATE: 02/03/2020

SCALE: 1" = 40'


SHEET NO:

S-02

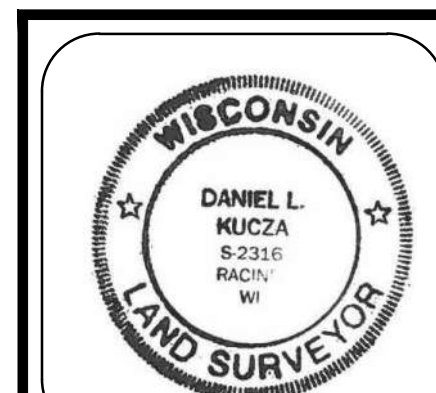

Summary of Airspace easement existing currently over Kilbourn.

See below

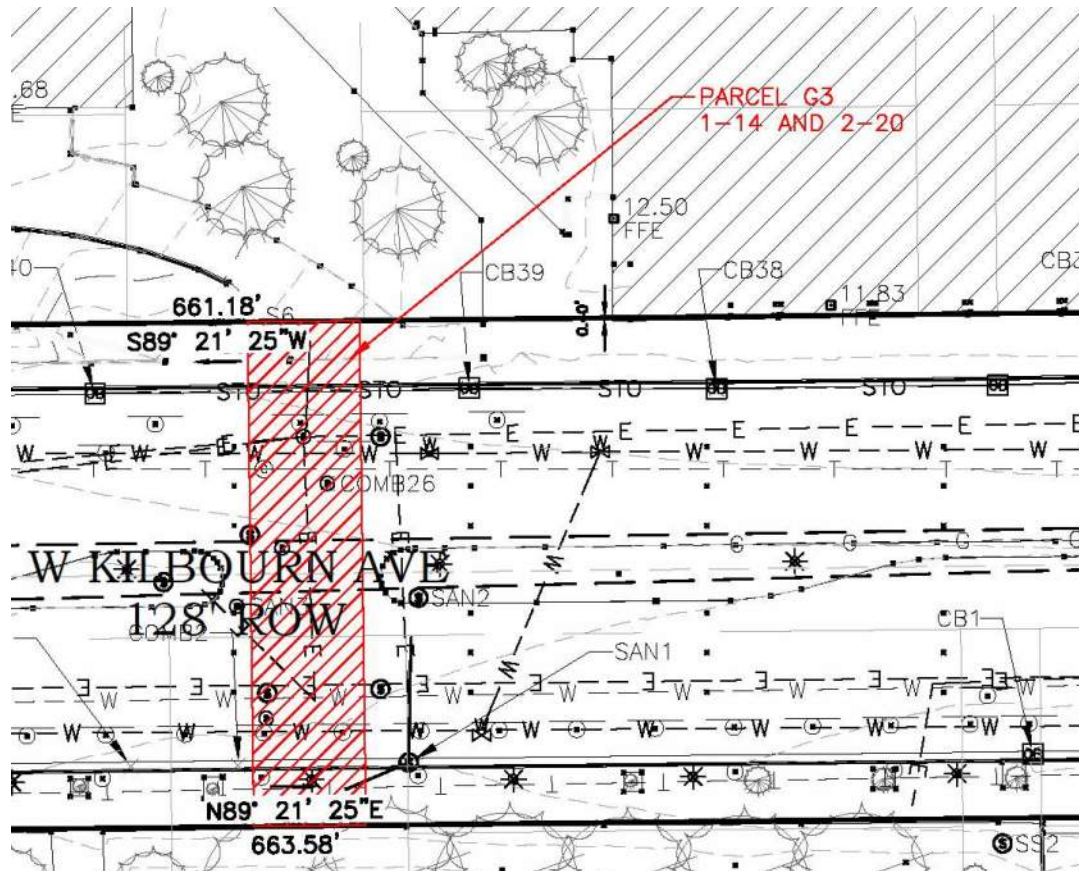

14. Covenants, air space rights, reverter clause as set forth in Quit Claim Deed recorded October 19, 1995, Reel 3653, Image 1135, as Document No. [7139672](#), including terms, conditions, restrictions and provisions relating to the use and maintenance therein.

20. Covenants, air space rights, reverter clause as set forth in Quit Claim Deed recorded October 19, 1995, Reel 3653, Image 1135, as Document No. [7139672](#), including terms, conditions, restrictions and provisions relating to the use and maintenance therein.

WELLS STREET AIR RIGHTS EASEMENT

That portion of that certain elevated enclosed structure, including air rights appurtenant thereto, lying within the following described traverse and below 110.00 feet, city datum, being a part of West Wells Street as originally platted in Plat of the Town of Milwaukee on the West Side of the River in the Northeast $\frac{1}{4}$ of Section 29, and part of West Wells Street as presently opened in Plat of the East Half in the Northwest $\frac{1}{4}$ of section 29, Township 7 North, Range 22 East, in the City of Milwaukee, County of Milwaukee, State of Wisconsin, bounded and described as follows:

Commencing at the Northwest corner of Block 63 in said Plat of East Half and the Northwest corner of Parcel 1 in Certified Survey Map No. 6234; thence N. $89^{\circ}-18'-10''$ E. along the north line of said block, 45.46 feet to the point of beginning of the Air Rights Easement to be described, the bottom elevation of the easement at this point is 32.00 feet, city datum; thence N. $00^{\circ}-41'-45''$ W. 79.98 feet to a point on the north line of West Wells Street, the bottom elevations of the easement at this point is 32.00 feet, city datum; thence N. $89^{\circ}-19'-45''$ E. along the north line of West Wells Street 138.50 feet to a point, the bottom elevation of the easement at this point is 32.00 feet, city datum; thence travel vertically downward 3.00 feet to a point, the bottom elevation of the easement at this point is 29.00 feet, city datum; thence N. $89^{\circ}-19'-45''$ E. along said north line 375.00 feet to a point, the bottom elevation of the easement at this point is 29.00 feet, city datum; thence travel vertically downward 1.00 feet to a point, the bottom elevation of the easement at this point is 28.00 feet, city datum; thence N. $89^{\circ}-19'-45''$ E. along said north line 87.50 feet to a point, the bottom elevation of the easement at this point is 28.00 feet, city datum; thence S. $00^{\circ}-41'-45''$ E. 79.70 feet to a point on the south line of West Wells Street, the bottom elevation of the easement at this point is 28.00 feet, city datum; thence S. $89^{\circ}-18'-10''$ W. along said south line 87.50 feet to a point, the bottom elevation of the easement at this point is 28.00 feet, city datum; thence travel vertically upward 1.00 feet to a point, the bottom elevation of the easement at this point is 29.00 feet, city datum; thence S. $89^{\circ}-18'-10''$ W. along said south line 375.00 feet to a point, the bottom elevation of the easement at this point is 29.00 feet, city datum; thence travel vertically upward 3.00 feet to a point, the bottom elevation of the easement at this point is 32.00 feet, city datum; thence S. $89^{\circ}-18'-10''$ W. along said south line 138.50 feet to the point of beginning, the bottom of the easement at this point is 32.00 feet.

parcel of land containing **47,983 SF**, or 1.10 Acre more or less, includes a volume of **3,806,388 Cubic Feet** of air space.

Area 1 = 11072.588 SF, elevation = 110-32 = 78', volume = 863,662 CF


Area 2 = 29934.995 SF, elevation = 110-29 = 81', volume = 2,424,734 CF

Area 3 = 6975.513 SF, elevation = 110-28 = 82', volume = 517,992 CF

**WCD EXPANSION
 WELLS ST AIR RIGHTS EASEMENT**

Milwaukee, WI

CEI PROJECT
 60-12124
 DESIGN BY:
 DLK
 DRAWN BY:
 MDG
 CHECKED BY:
 DLK
 DATE:
 09/20/2021
 SHEET NO:
EX-4

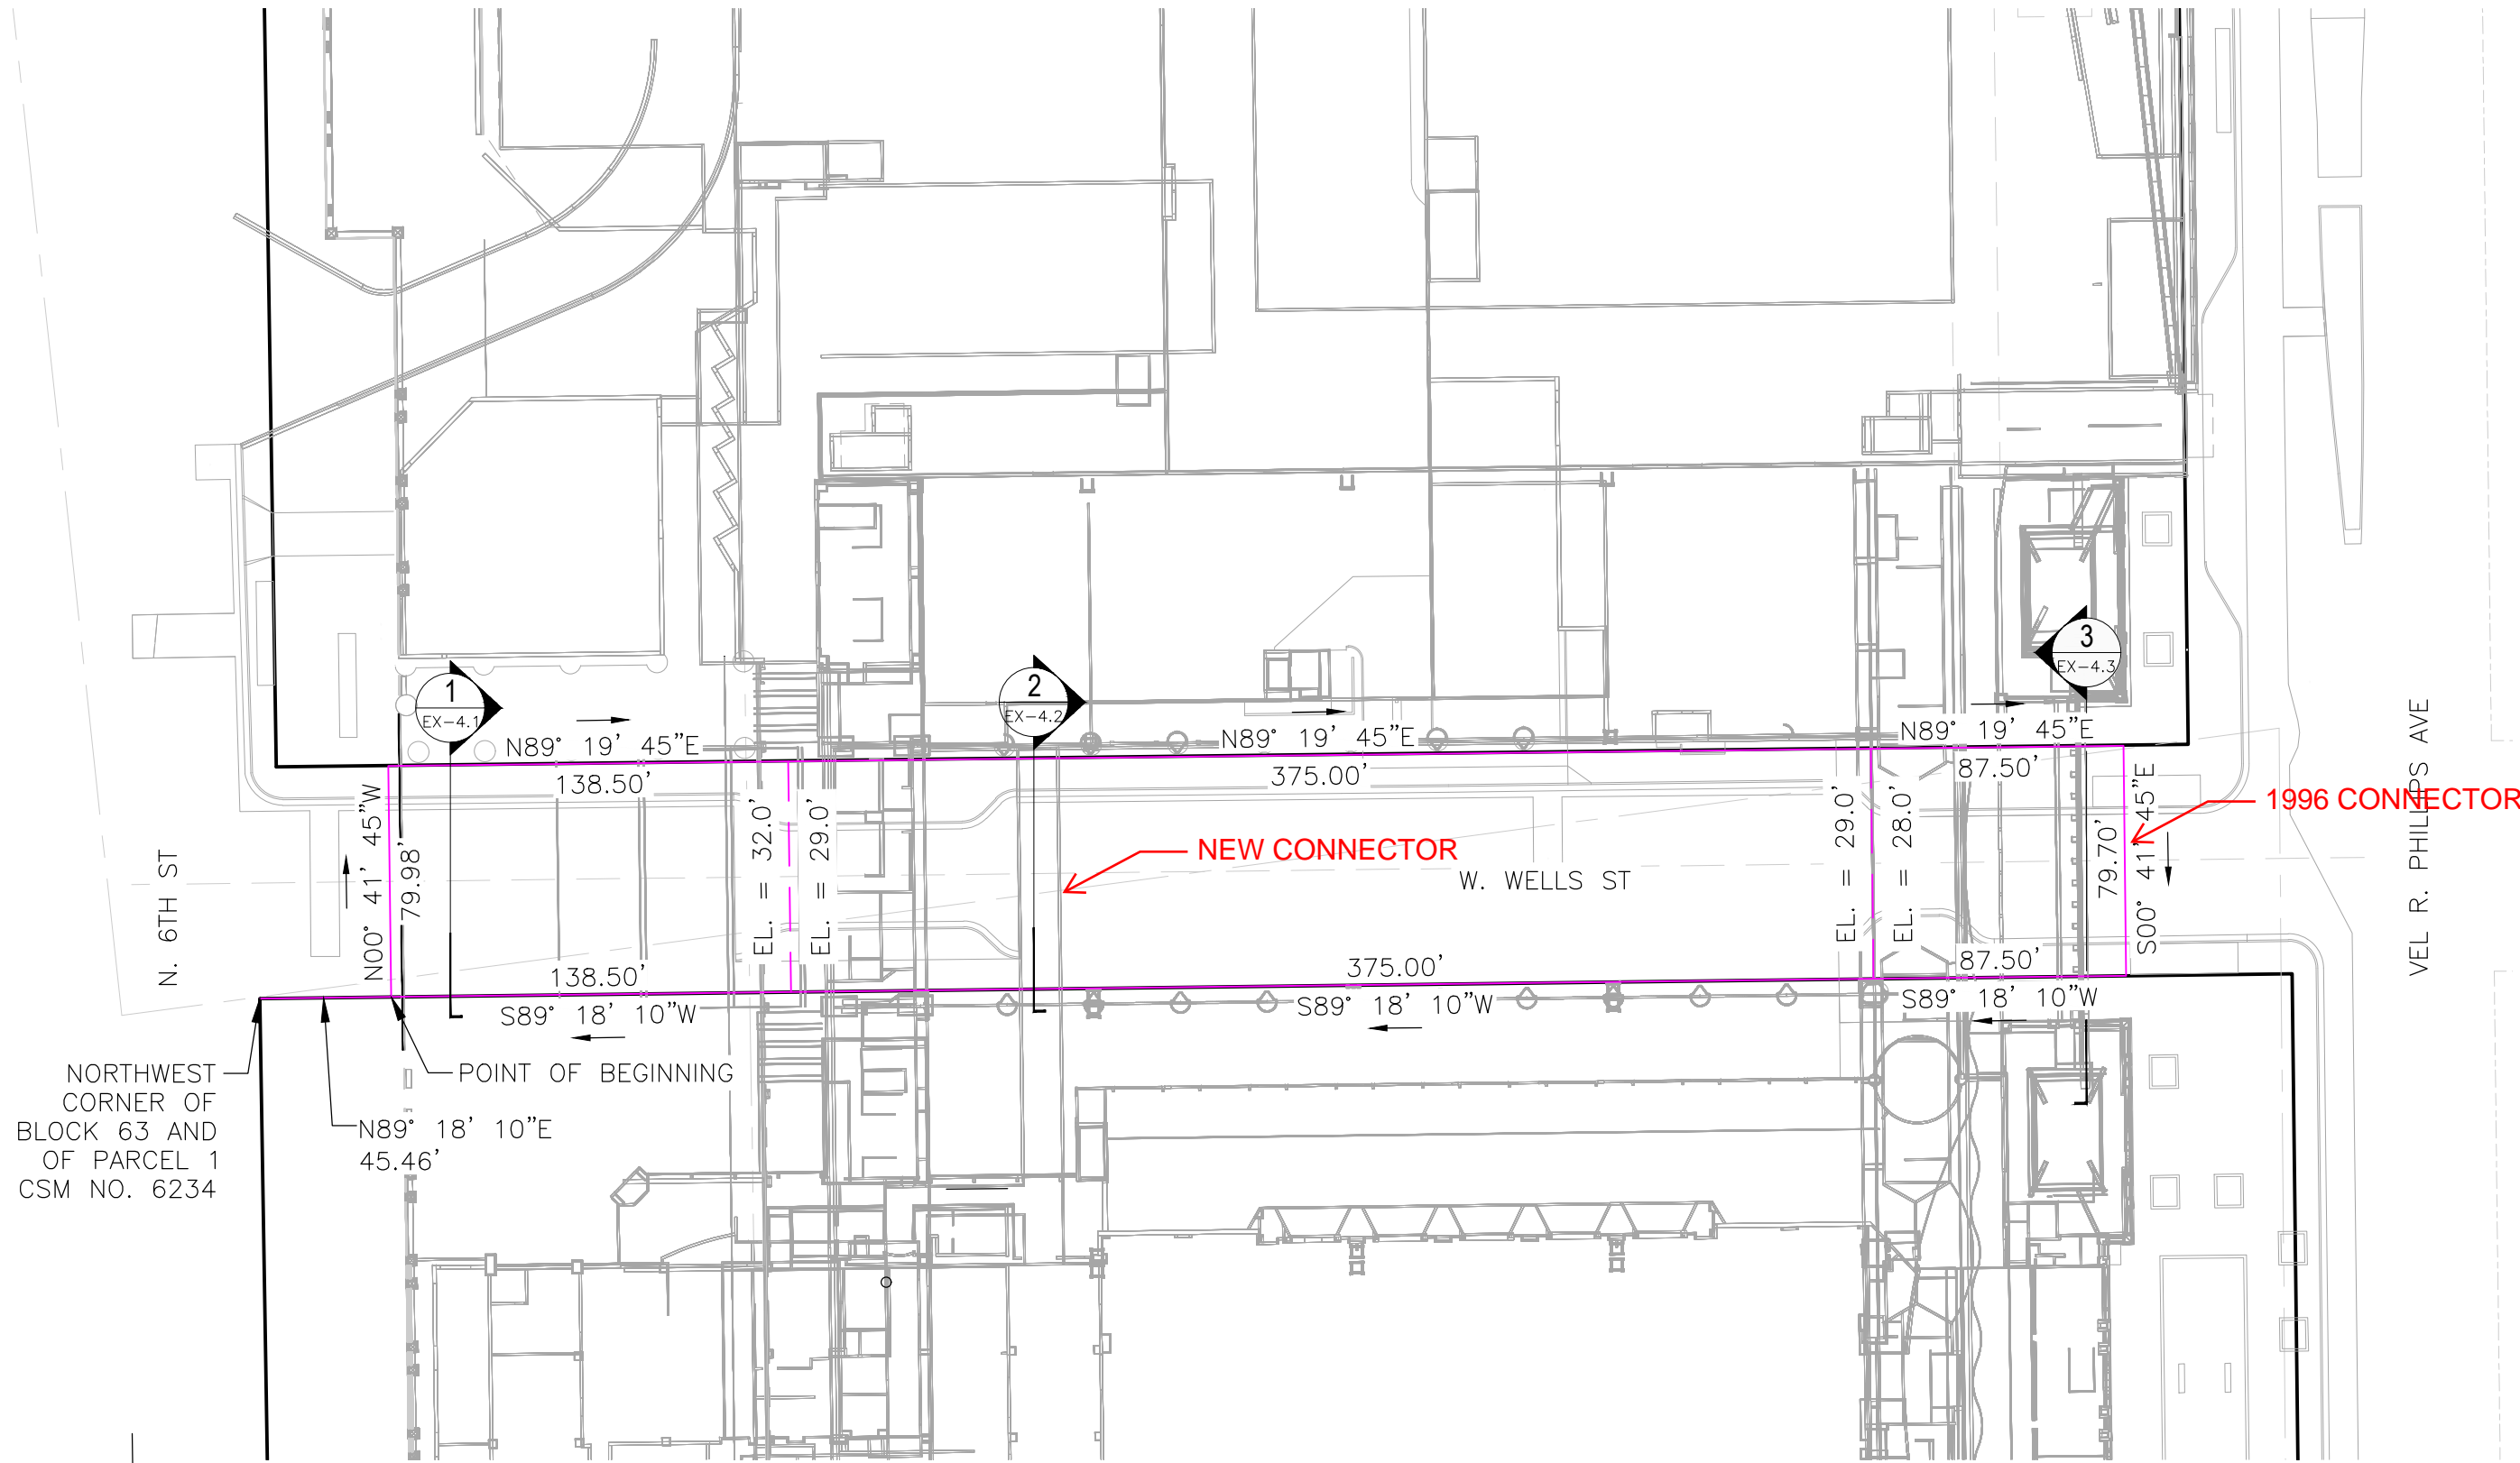


EL. = 30.0'
 EL. = 29.0'

NOTE:
 THIS DENOTES AN ELEVATION CHANGE AT THE BOTTOM OF THE AIR RIGHTS EASEMENT. AT THE POINT THIS LINE IS DRAWN, THE ELEVATION CHANGES FROM ONE GIVEN ELEVATION TO THE OTHER GIVEN ELEVATION BASED ON THE DIRECTION BEING TRAVELED THROUGH THE EASEMENT.

COLLINS ENGINEERS, INC. ASSUMES NO RESPONSIBILITY FOR DAMAGES, LIABILITY, OR COSTS RESULTING FROM CHANGES OR ALTERATIONS MADE TO THIS PLAN WITHOUT THE EXPRESSED WRITTEN CONSENT OF COLLINS ENGINEERS, INC.

WELLS ST AIR RIGHTS EASEMENT
 SCALE: 1" = 60'
 0 30' 60'

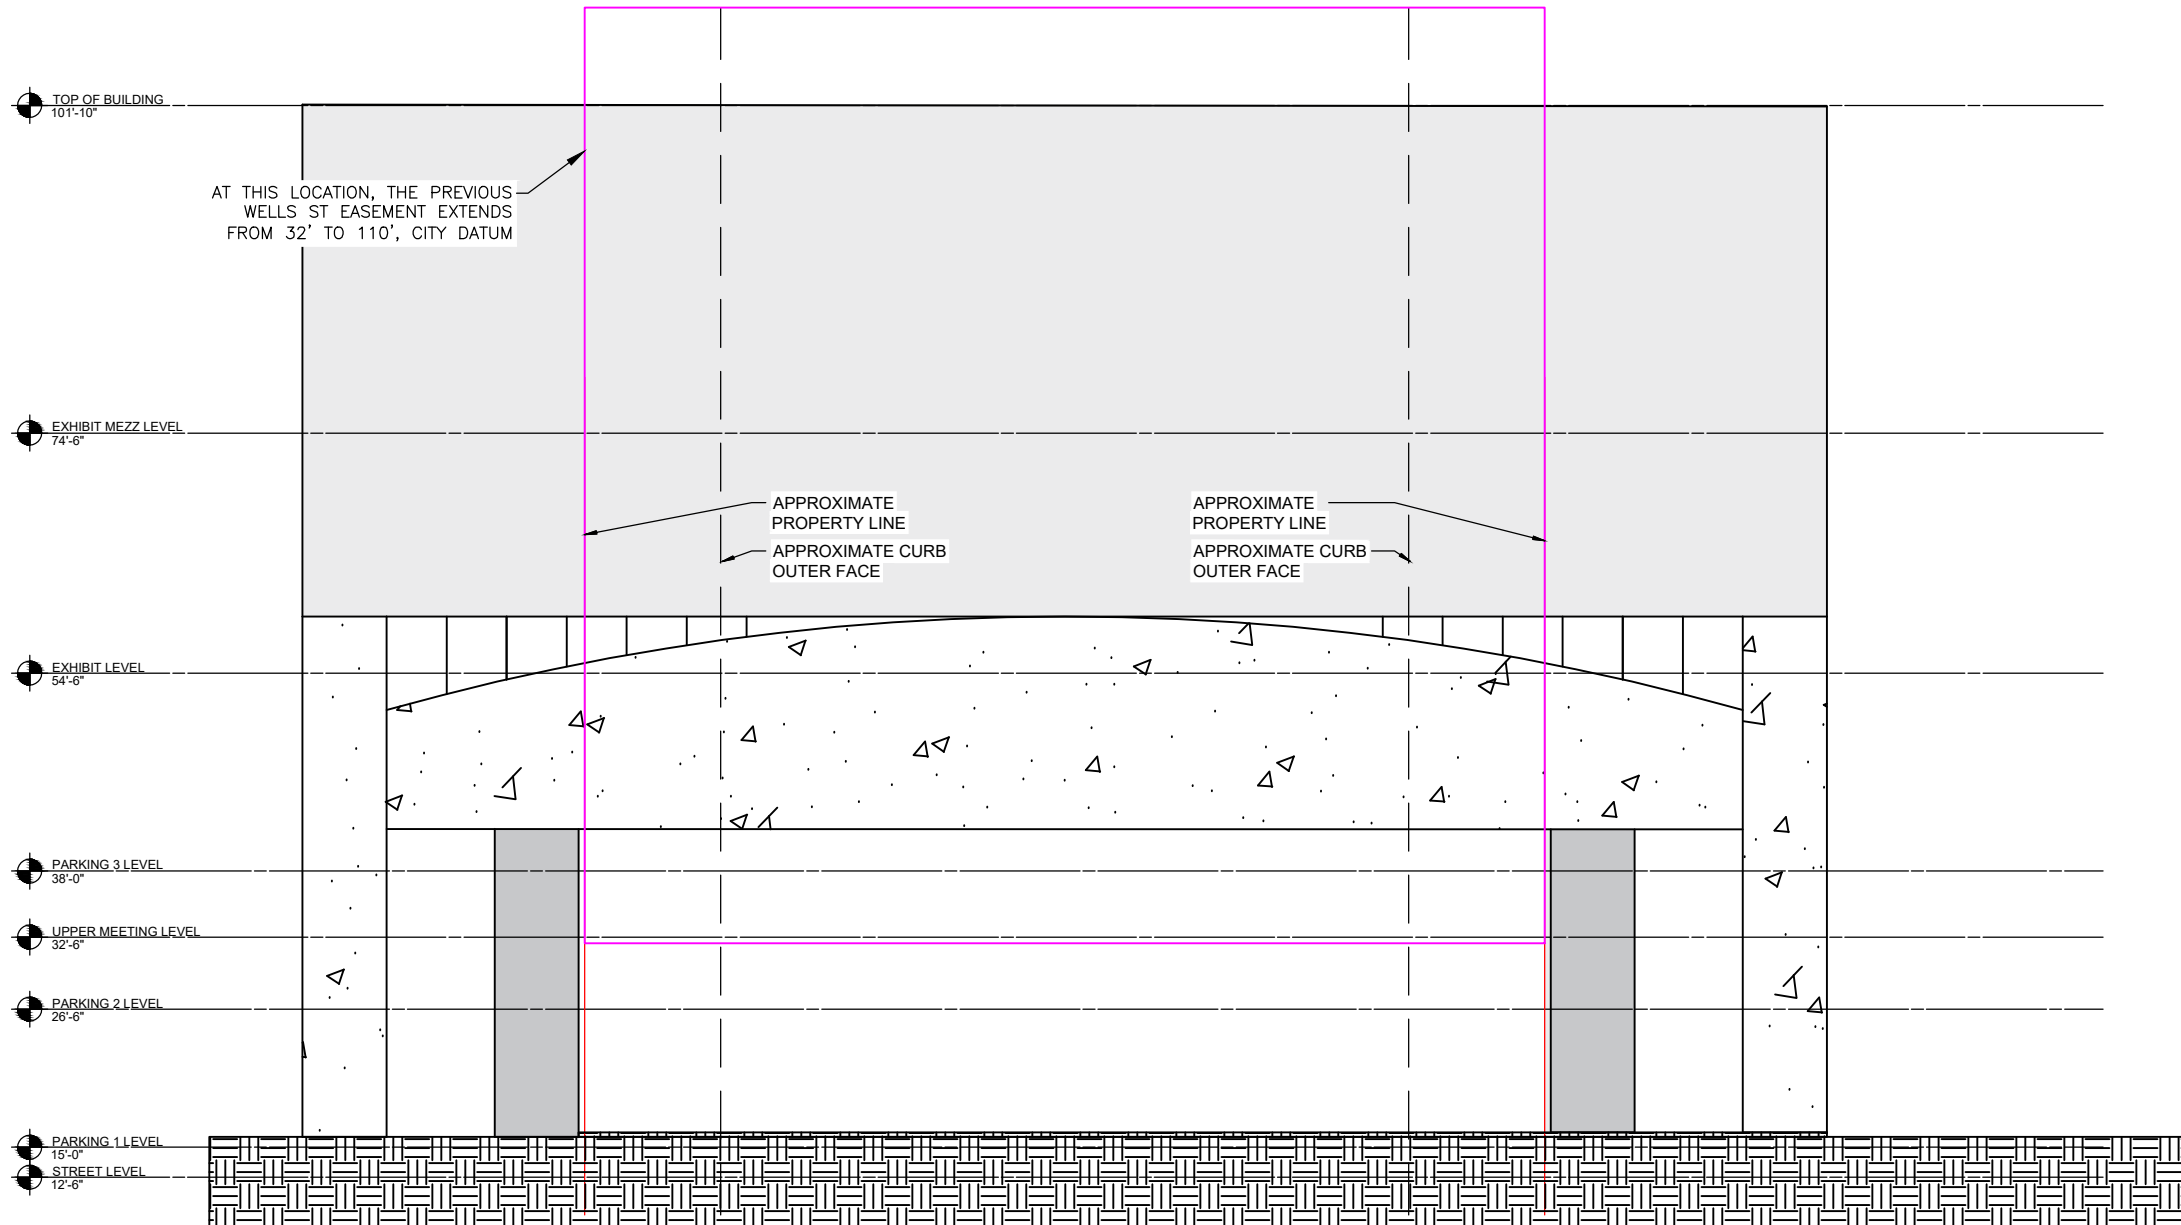

1 WELLS ST AIR RIGHTS EASEMENT DETAIL
NOT TO SCALE

Reference next sheet for real time photo


COLLINS ENGINEERS, INC. ASSUMES NO RESPONSIBILITY FOR DAMAGES, LIABILITY, OR COSTS RESULTING FROM CHANGES OR ALTERATIONS MADE TO THIS PLAN WITHOUT THE EXPRESSED WRITTEN CONSENT OF COLLINS ENGINEERS, INC.


COLLINS ENGINEERS[®]
2033 West Howard Ave.
Milwaukee, WI 53221
Phone: 414-282-6905
Fax: 414-282-6955

WISCONSIN CENTER DISTRICT
400 W. WISCONSIN AVE
MILWAUKEE, WI 53203

**WCD EXPANSION
WELLS ST AIR RIGHTS EASEMENT
DETAILS**
Milwaukee, WI

CEI PROJECT 60-12124
DESIGN BY: DLK
DRAWN BY: MDG
CHECKED BY: DLK
DATE: 09/20/2021
SHEET NO: EX-4.1

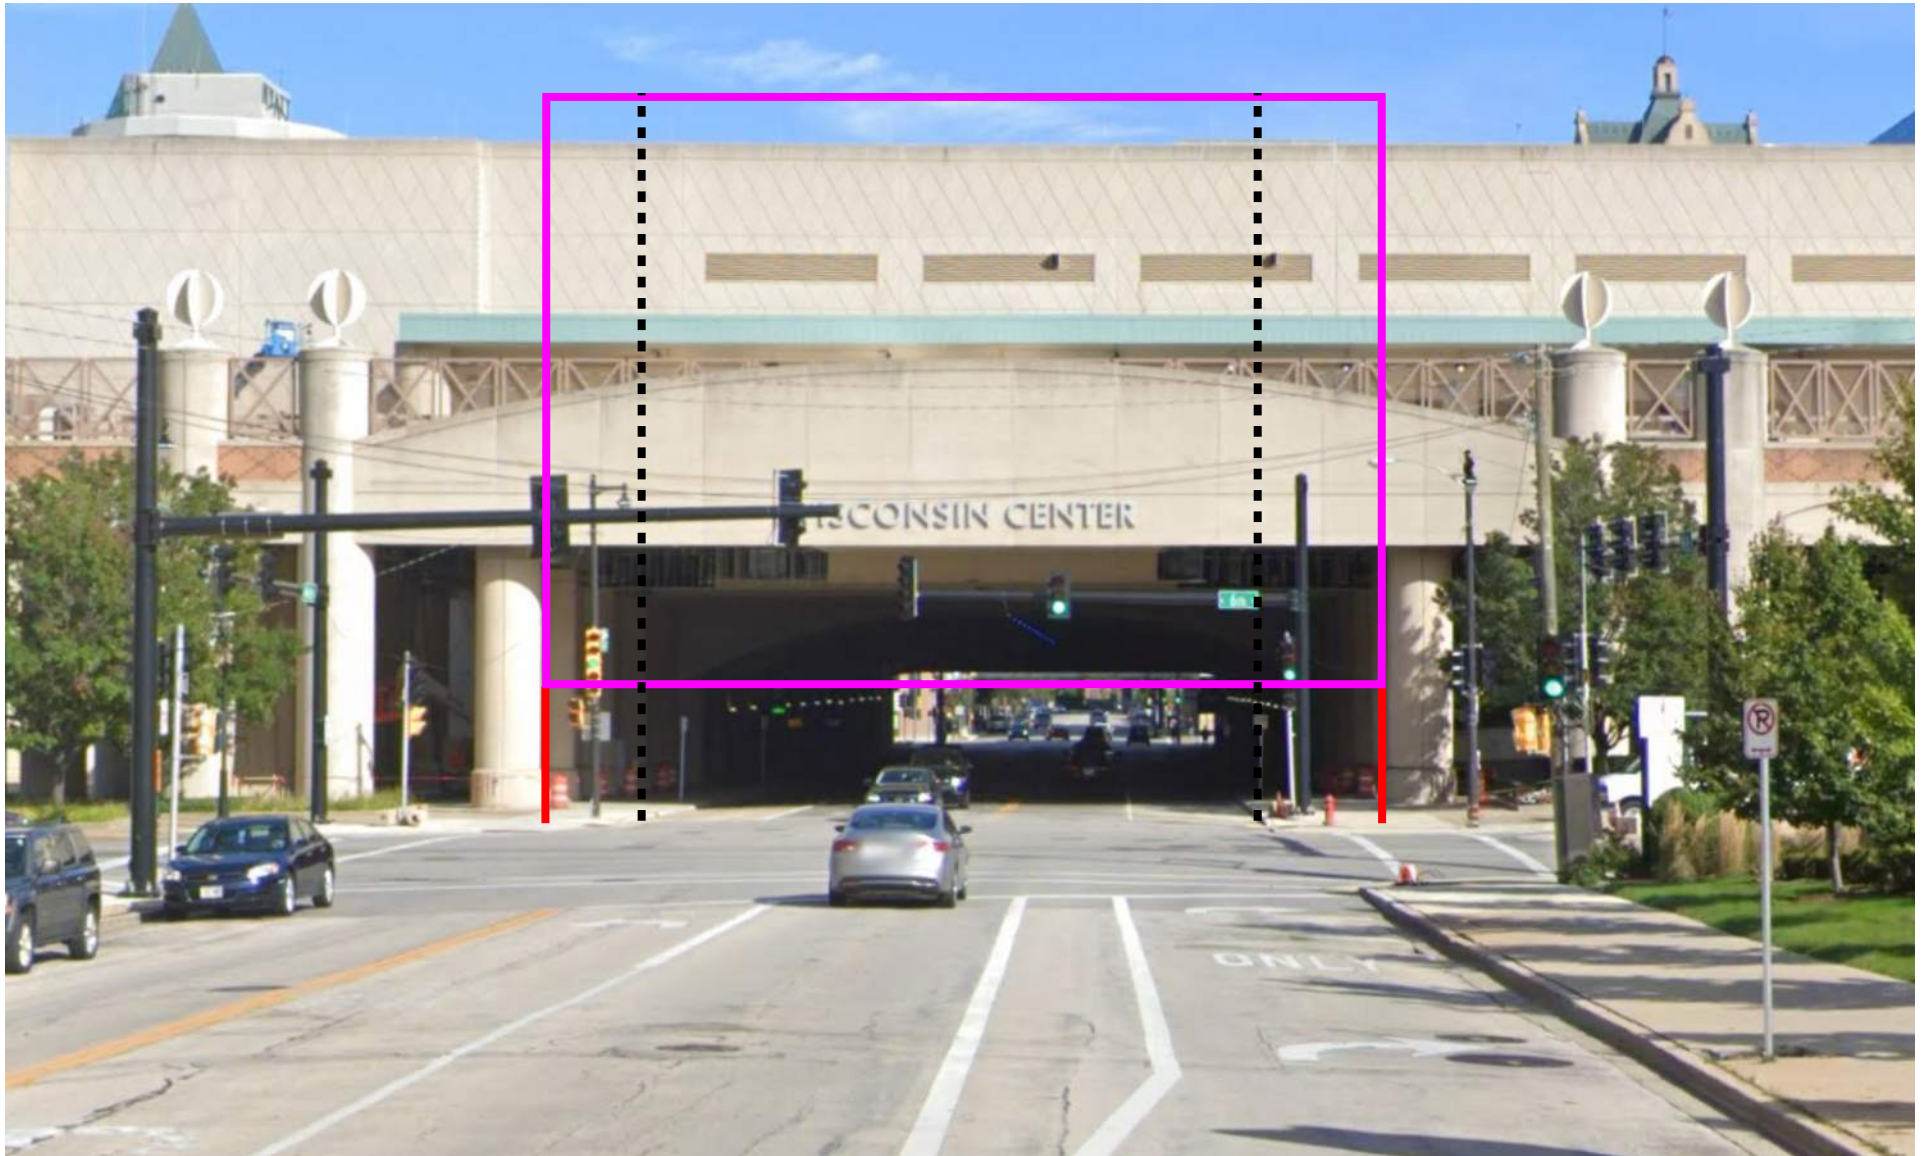

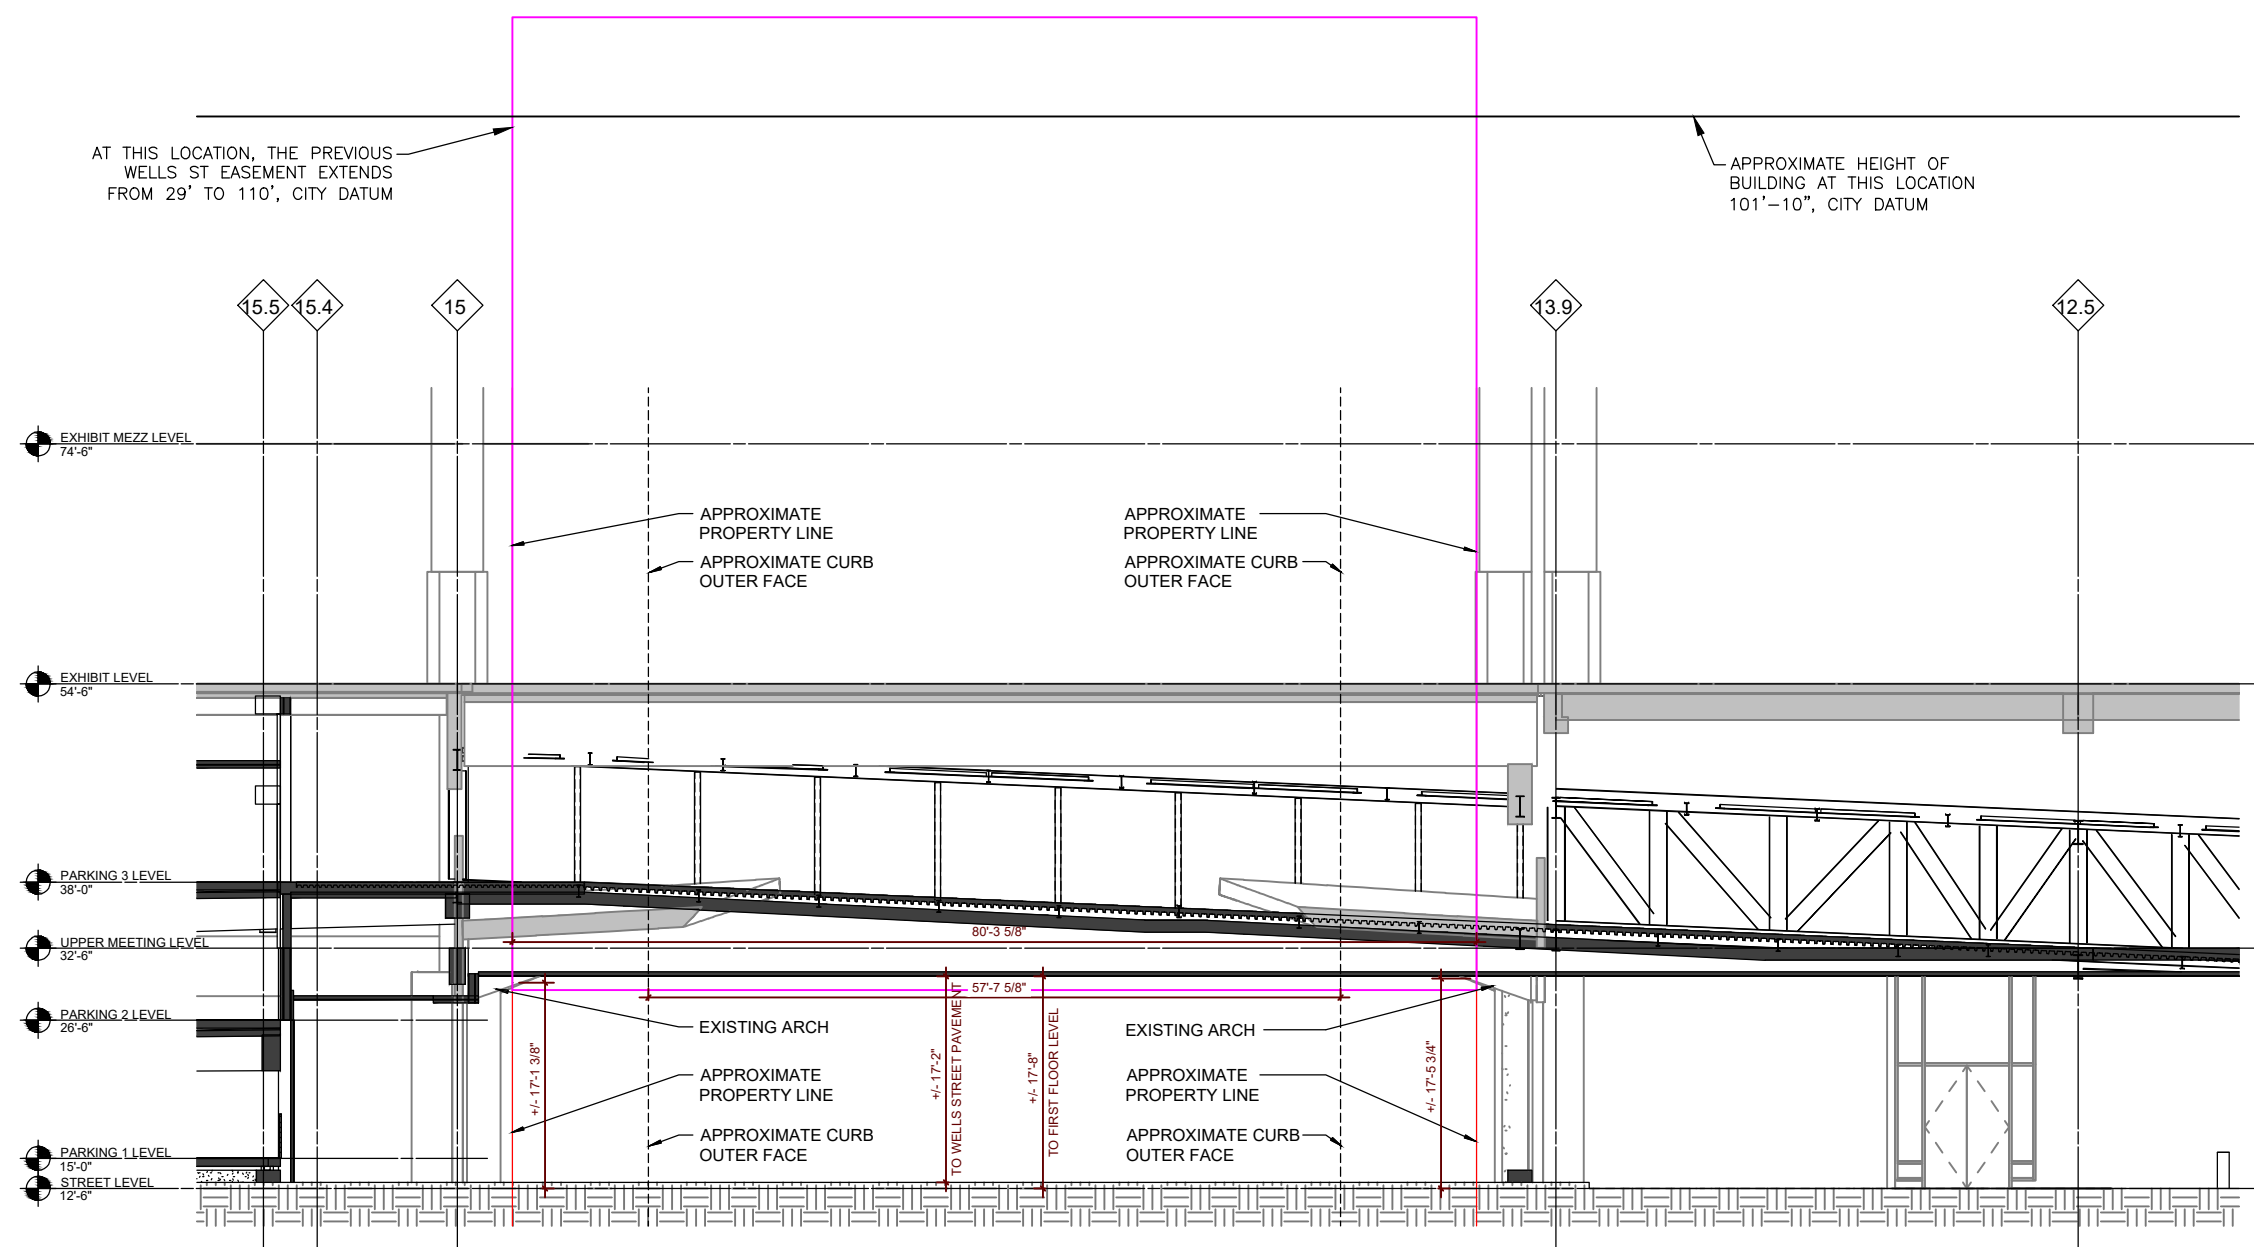

2
WELLS ST AIR RIGHTS EASEMENT DETAIL
 NOT TO SCALE

Reference next sheet for renderings of new building connector

COLLINS ENGINEERS, INC. ASSUMES NO RESPONSIBILITY FOR DAMAGES, LIABILITY, OR COSTS RESULTING FROM CHANGES OR ALTERATIONS MADE TO THIS PLAN WITHOUT THE EXPRESSED WRITTEN CONSENT OF COLLINS ENGINEERS, INC.

COLLINS ENGINEERS^{PC}
 2033 West Howard Ave.
 Milwaukee, WI 53221
 Phone: 414-282-6905
 Fax: 414-282-6955


WISCONSIN CENTER DISTRICT
 400 W. WISCONSIN AVE
 MILWAUKEE, WI 53203

**WCD EXPANSION
 WELLS ST AIR RIGHTS EASEMENT
 DETAILS**
 Milwaukee, WI

CEI PROJECT 60-12124
 DESIGN BY: DLK
 DRAWN BY: MDG
 CHECKED BY: DLK
 DATE: 09/20/2021
 SHEET NO: **EX-4.2**


Looking East


New building connector

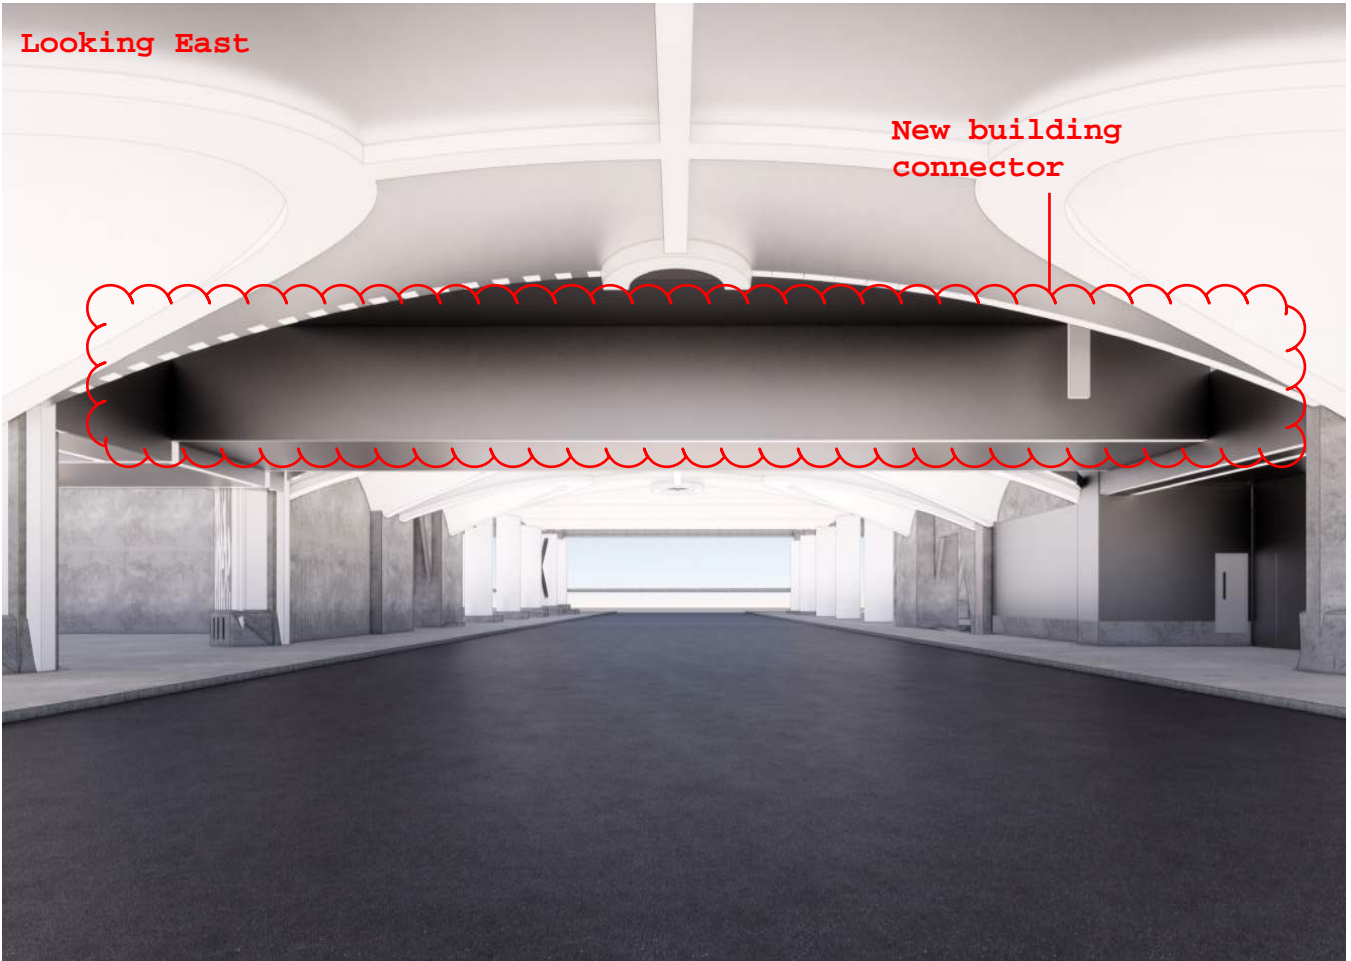

Looking West

New building connector

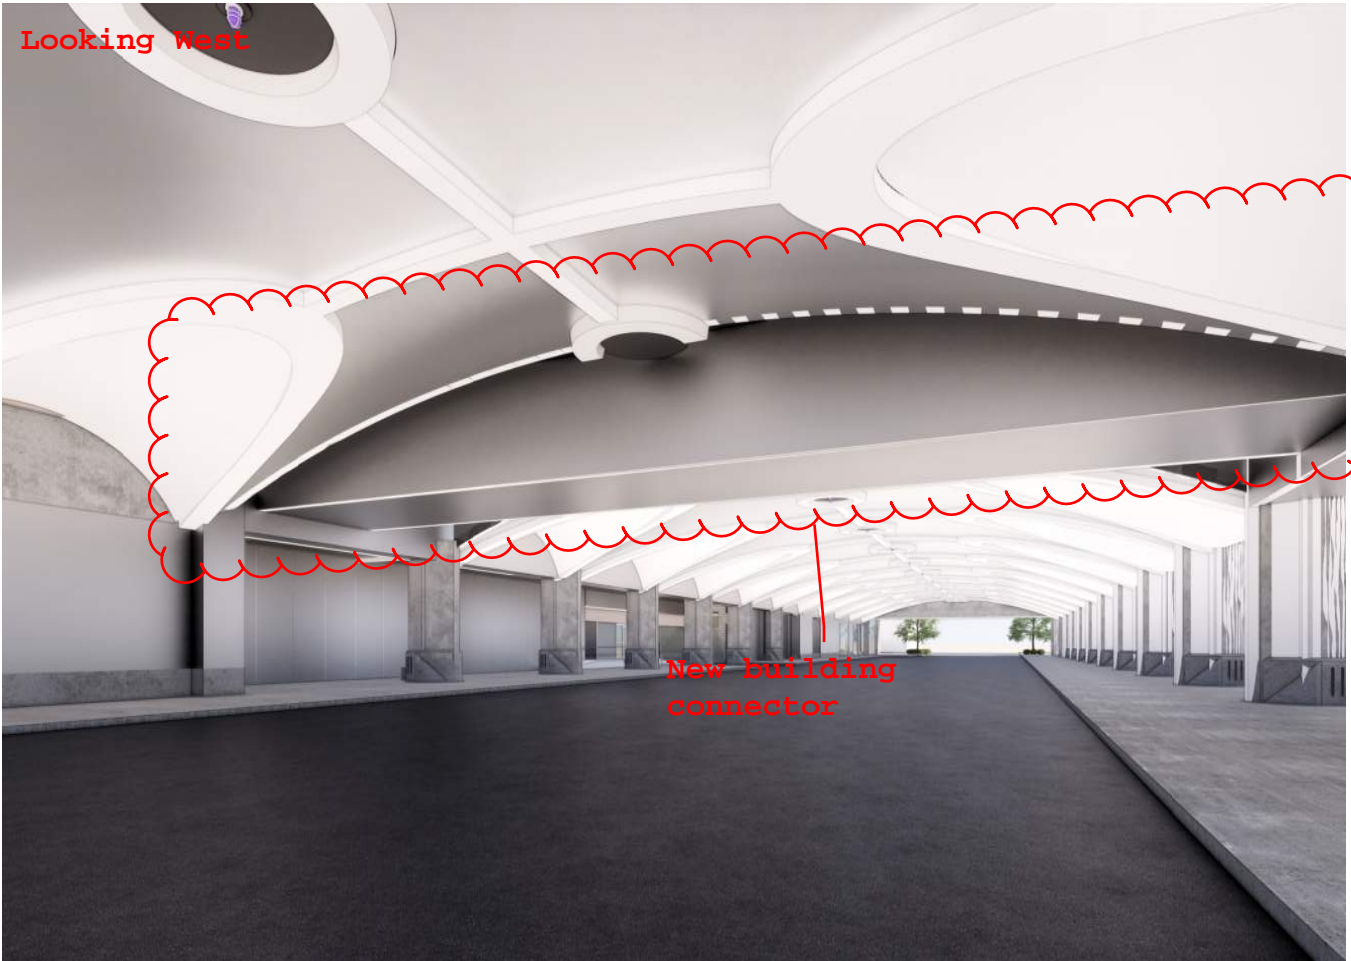

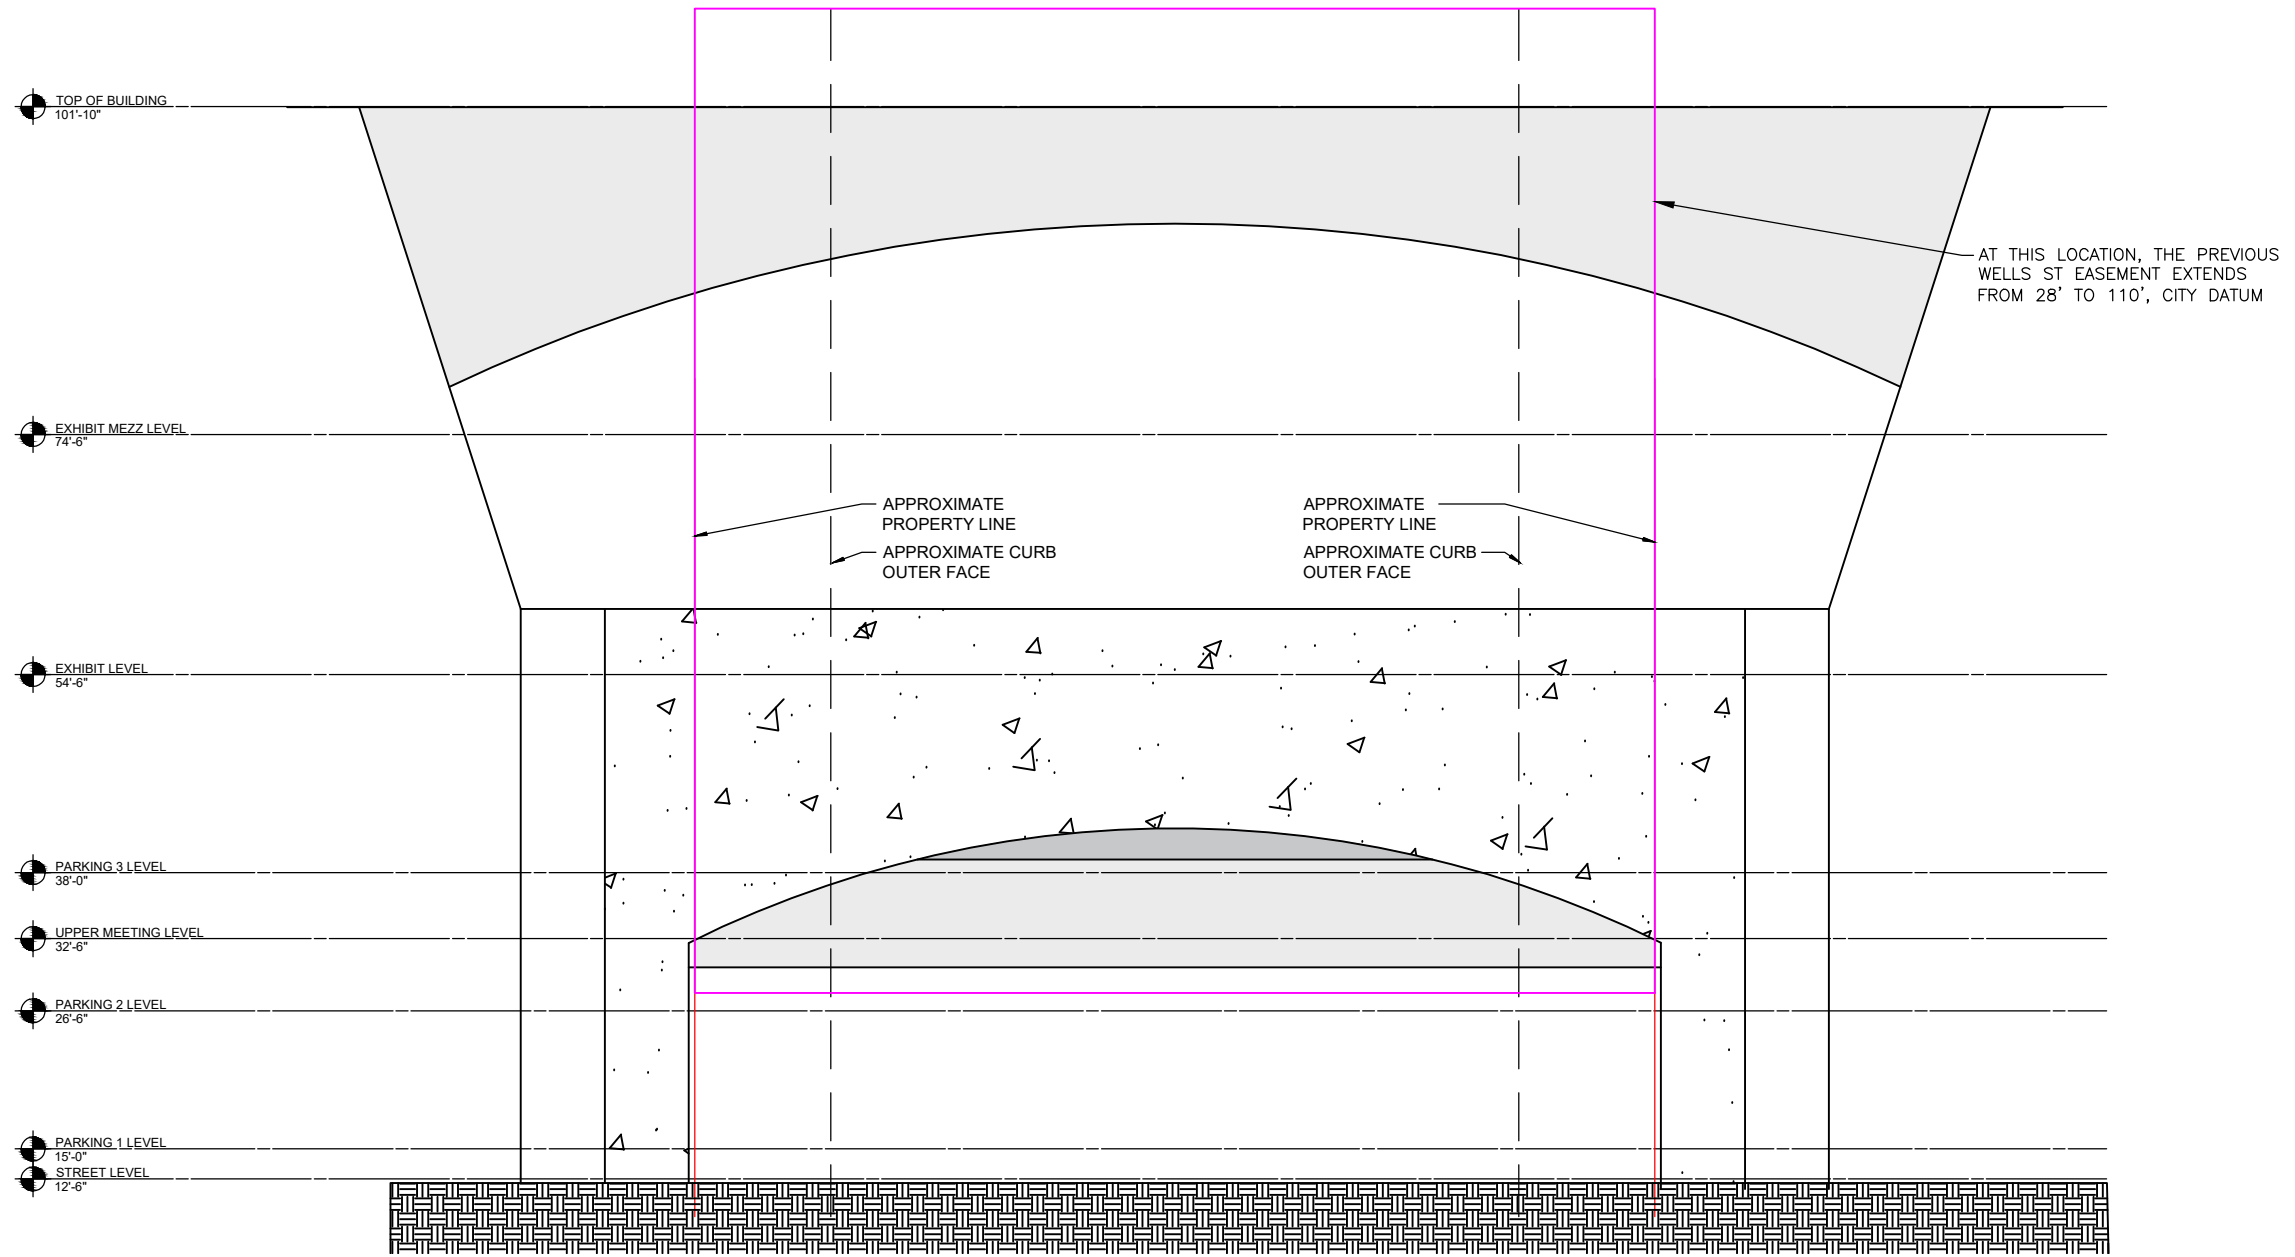

3 WELLS ST AIR RIGHTS EASEMENT DETAIL
NOT TO SCALE

Reference next sheet for real time photo

COLLINS ENGINEERS^{PC}
2033 West Howard Ave.
Milwaukee, WI 53221
Phone: 414-282-6905
Fax: 414-282-6955

WISCONSIN
CENTER DISTRICT
400 W. WISCONSIN AVE
MILWAUKEE, WI 53203

WCD EXPANSION
WELLS ST AIR RIGHTS EASEMENT
DETAILS
Milwaukee, WI

CEI PROJECT
60-12124
DESIGN BY:
DLK
DRAWN BY:
MDG
CHECKED BY:
DLK
DATE:
09/20/2021
SHEET NO:
EX-4.3

COLLINS ENGINEERS, INC. ASSUMES NO RESPONSIBILITY FOR DAMAGES, LIABILITY, OR COSTS RESULTING FROM CHANGES OR ALTERATIONS MADE TO THIS PLAN WITHOUT THE EXPRESSED WRITTEN CONSENT OF COLLINS ENGINEERS, INC.

