



CERTIFICATE OF APPROPRIATENESS APPLICATION FORM

Incomplete applications will not be processed for Commission review.
Please print legibly.

1. HISTORIC NAME OF PROPERTY OR HISTORIC DISTRICT: (if known)

SIXTH CHURCH OF CHRIST SCIENTIST

ADDRESS OF PROPERTY:

1036 N. VAN BUREN STREET

2. NAME AND ADDRESS OF OWNER:

Name(s): BREW CITY CHURCH, INC.

Address: 1036 N. VAN BUREN STREET

City: MILWAUKEE State: WISC. ZIP: 53202-3218

Email: davearnone@brewcitychurch.org

Telephone number (area code & number) Daytime: (262) 939-9466 Evening:

3. APPLICANT, AGENT OR CONTRACTOR: (if different from owner)

Name(s): OWNER

Address:

City: State: ZIP Code:

Email:

Telephone number (area code & number) Daytime: Evening:

4. ATTACHMENTS: (Because projects can vary in size and scope, please call the HPC Office at 414-286-5712 for submittal requirements)

A. REQUIRED FOR MAJOR PROJECTS:

☒ Photographs of affected areas & all sides of the building (annotated photos recommended)

Sketches and Elevation Drawings (1 full size and 1 reduced to 11" x 17" or 8 1/2" x 11")
A digital copy of the photos and drawings is also requested.

Material and Design Specifications (see next page)

B. NEW CONSTRUCTION ALSO REQUIRES:

Floor Plans (1 full size and 1 reduced to a maximum of 11" x 17")

☒ Site Plan showing location of project and adjoining structures and fences

**PLEASE NOTE: YOUR APPLICATION CANNOT BE PROCESSED UNLESS
BOTH PAGES OF THIS FORM ARE PROPERLY COMPLETED
AND SIGNED.**

5. **DESCRIPTION OF PROJECT:**

Tell us what you want to do. Describe all proposed work including materials, design, and dimensions. Additional pages may be attached.

WE INTEND TO MODIFY THE AS-BUILT
NON-COMPLIANT SIGN IN SUBSTANTIAL
CONFORMANCE WITH THE SUGGESTIONS
PROVIDED BY THE CITY OFFICE OF THE
HISTORIC PRESERVATION COMMISSION.
SEE ATTACHED DRAWINGS.

6. **SIGNATURE OF APPLICANT:**



Signature

DAVID ARNONE EOO

Please print or type name

1/25/17

Date

This form and all supporting documentation **MUST** arrive by 12:00 noon on the deadline date established to be considered at the next Historic Preservation Commission Meeting. Any information not provided to staff in advance of the meeting will not be considered by the Commission during their deliberation. Please call if you have any questions and staff will assist you.

Hand Deliver or Mail Form to:
Historic Preservation Commission
City Clerk's Office
200 E. Wells St. Room B-4
Milwaukee, WI 53202

PHONE: (414) 286-5722

FAX: (414) 286-3004

www.milwaukee.gov/hpc

Or click the **SUBMIT** button to automatically email this form for submission.

SUBMIT



6/22/12


A1.0


Sign Revamp
Brew City Church
1036 N Van Buren Street
Milwaukee, Wisconsin 53202

Scale: As Shown
Date: 1/24/2017
Drawn by: ARC

ARC Architectural Group, L.L.C.
546 State Street
Racine, Wisconsin 53402
P 262-637-6100
F 262-637-6105

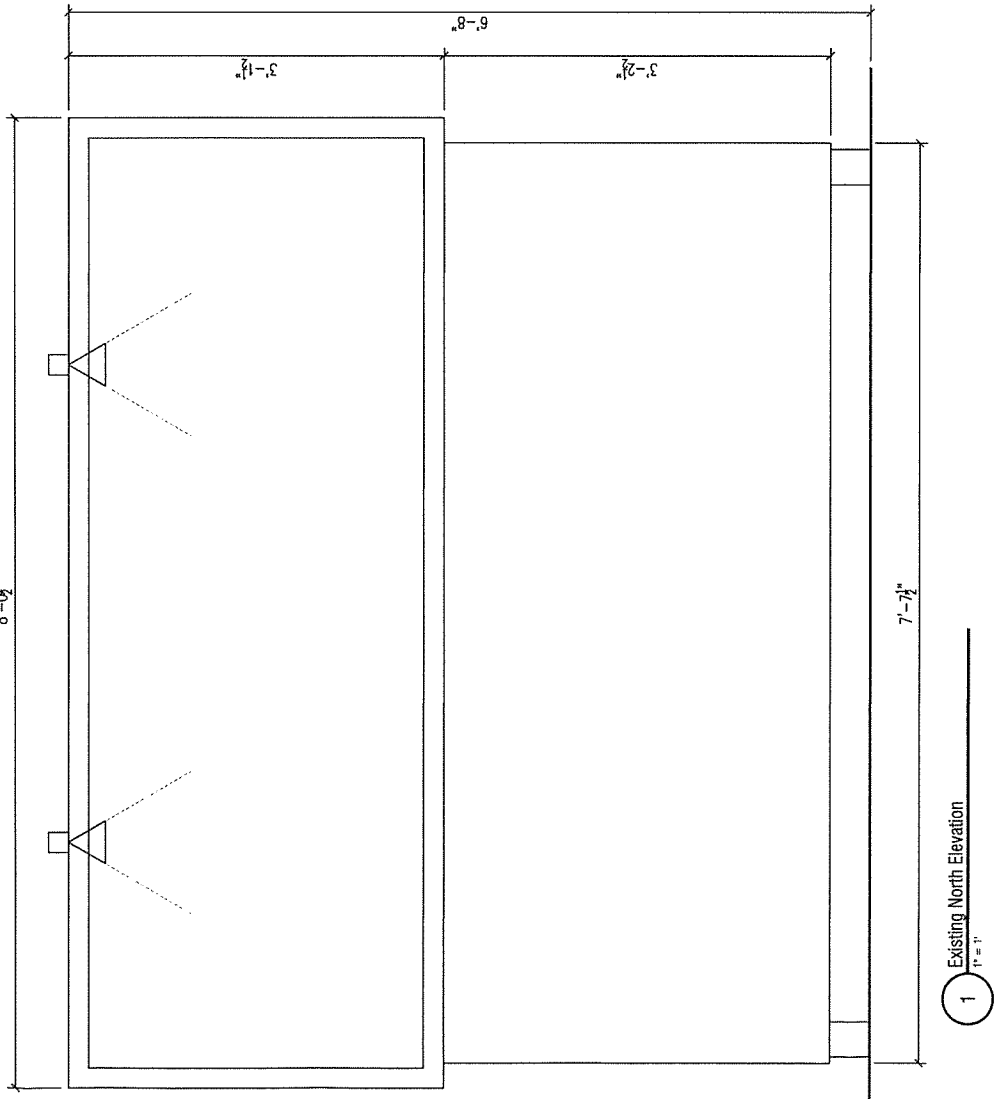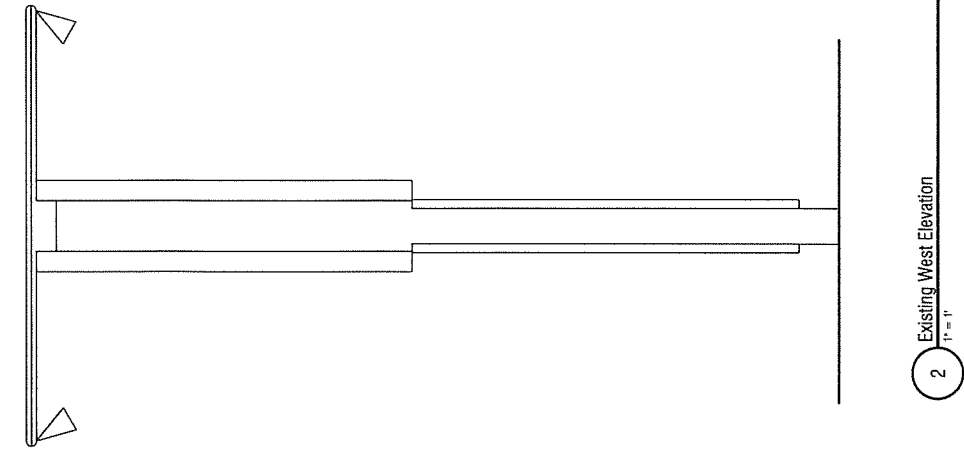

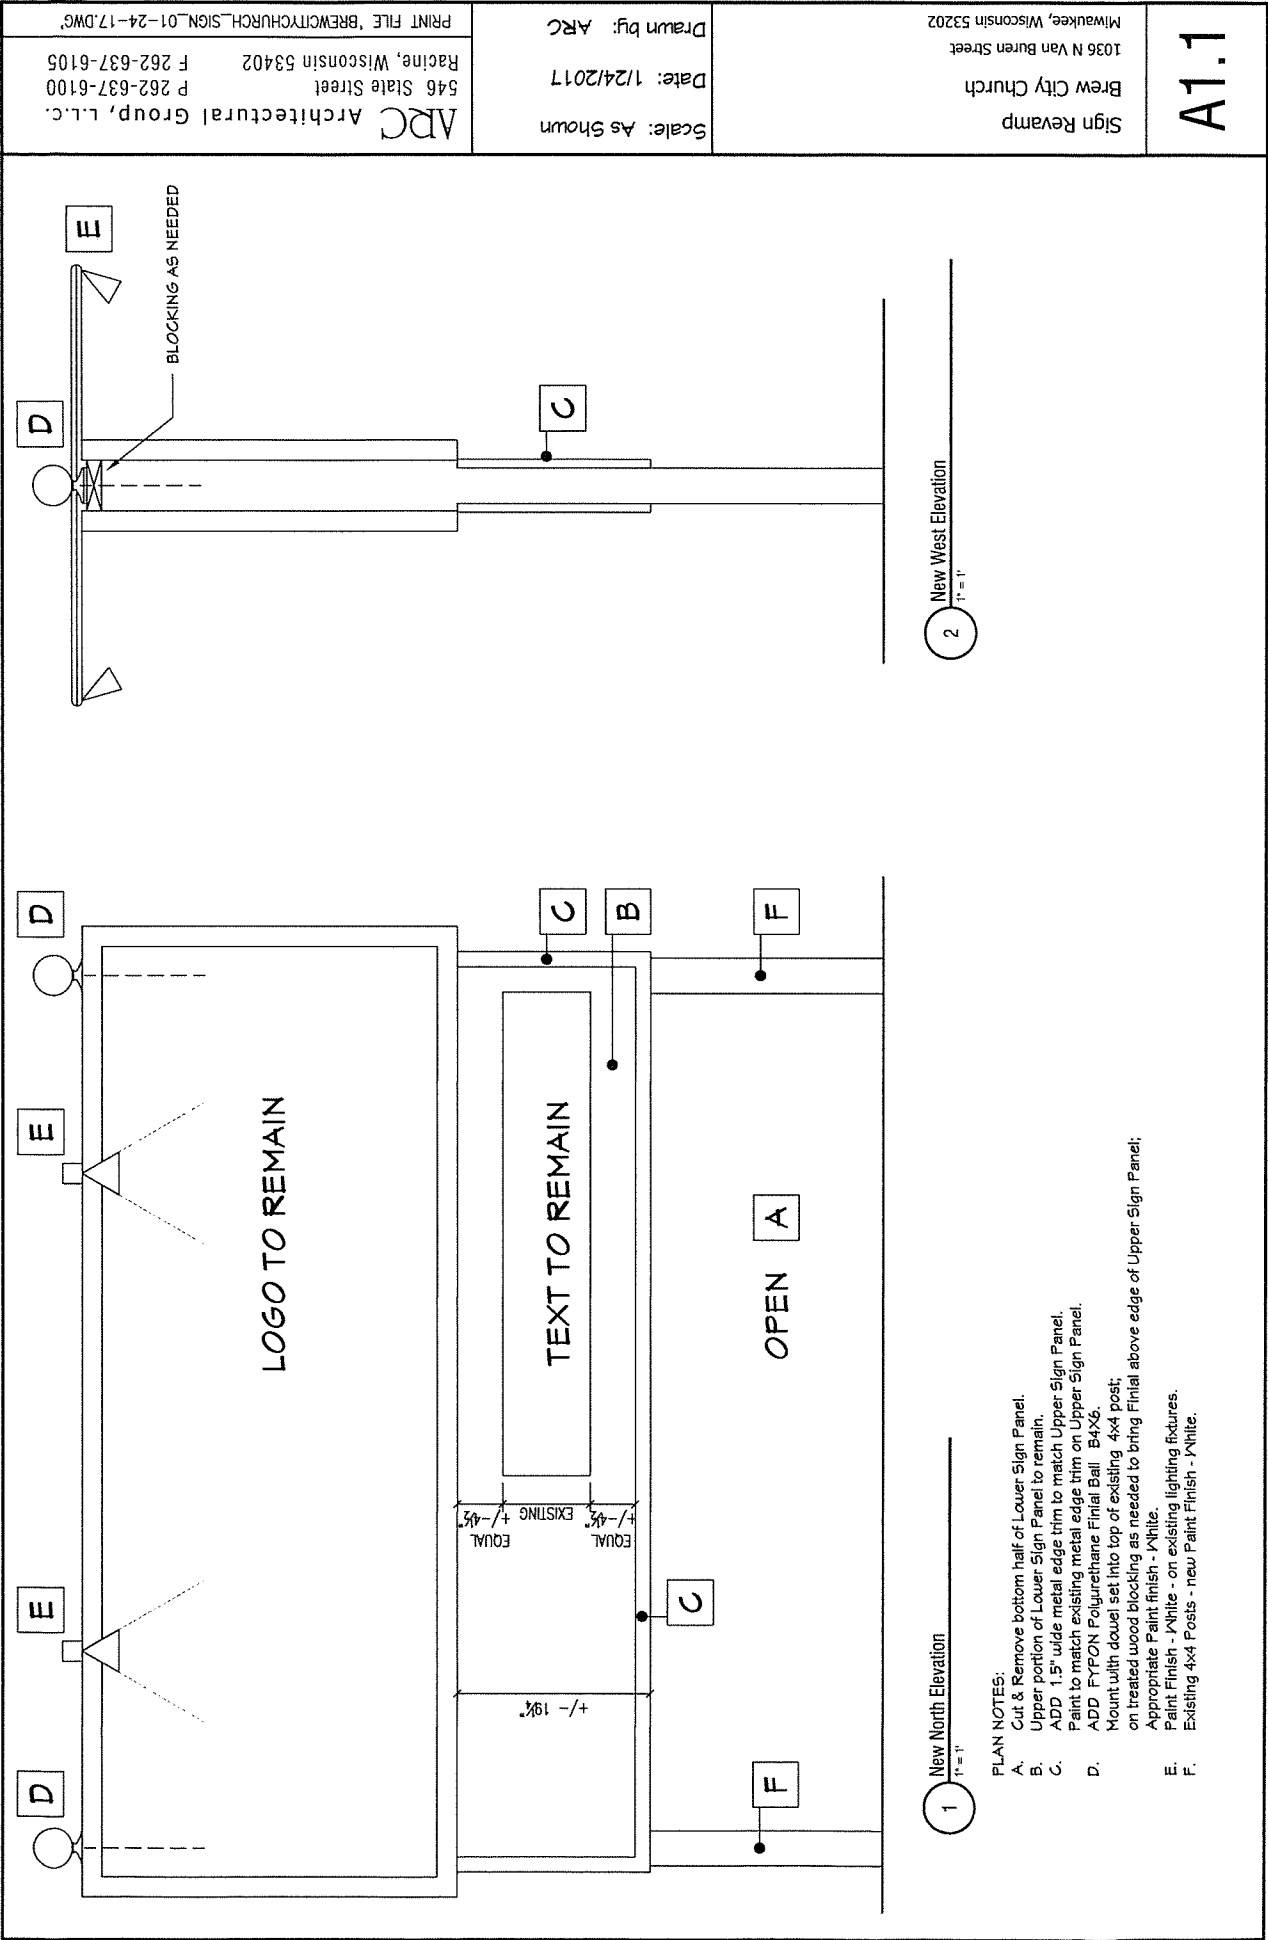

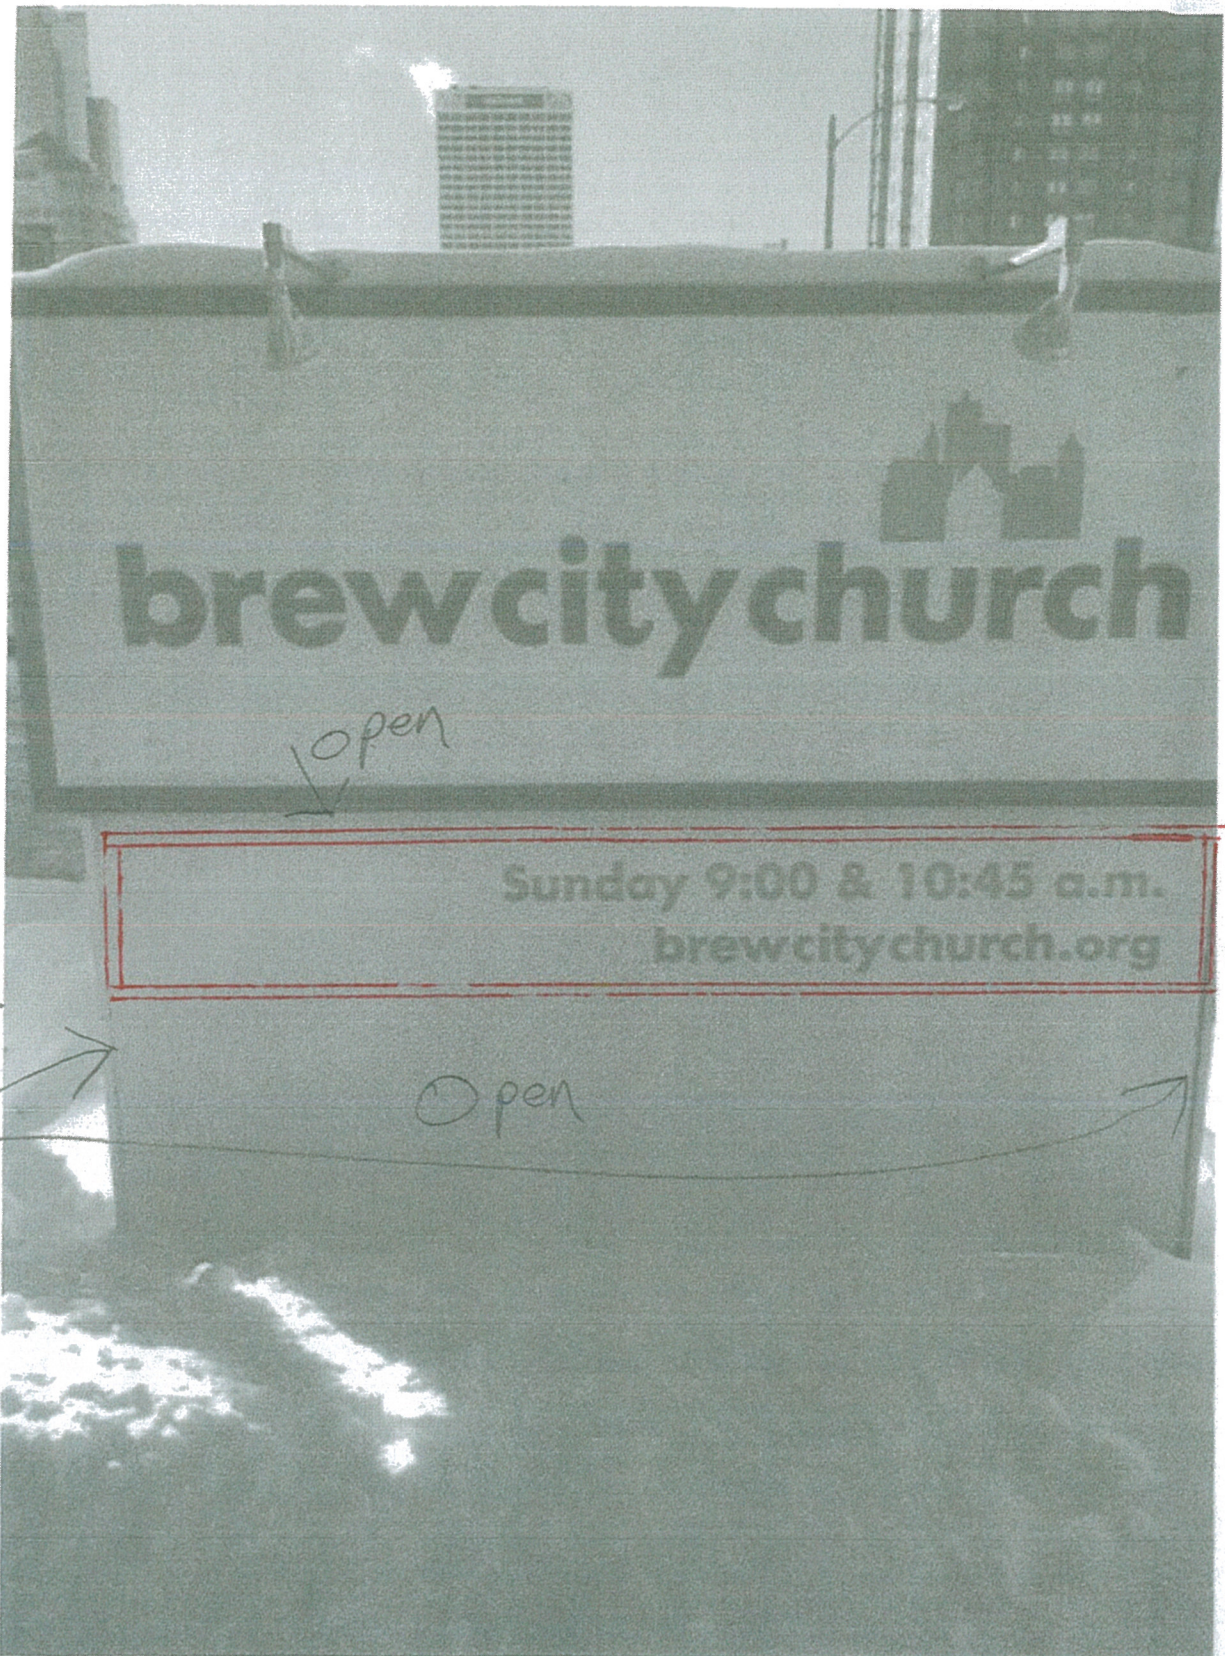

brewcitychurch

Open

Sunday 9:00 & 10:45 a.m.
brewcitychurch.org

red
=
metal
trim

Open

trim
edges
in dark
metal


or
dark-
painted
wood




brew city church

Sunday 9:00 & 10:45 a.m.
brewcitychurch.org

Mykenes
Open to All
Brew City Church

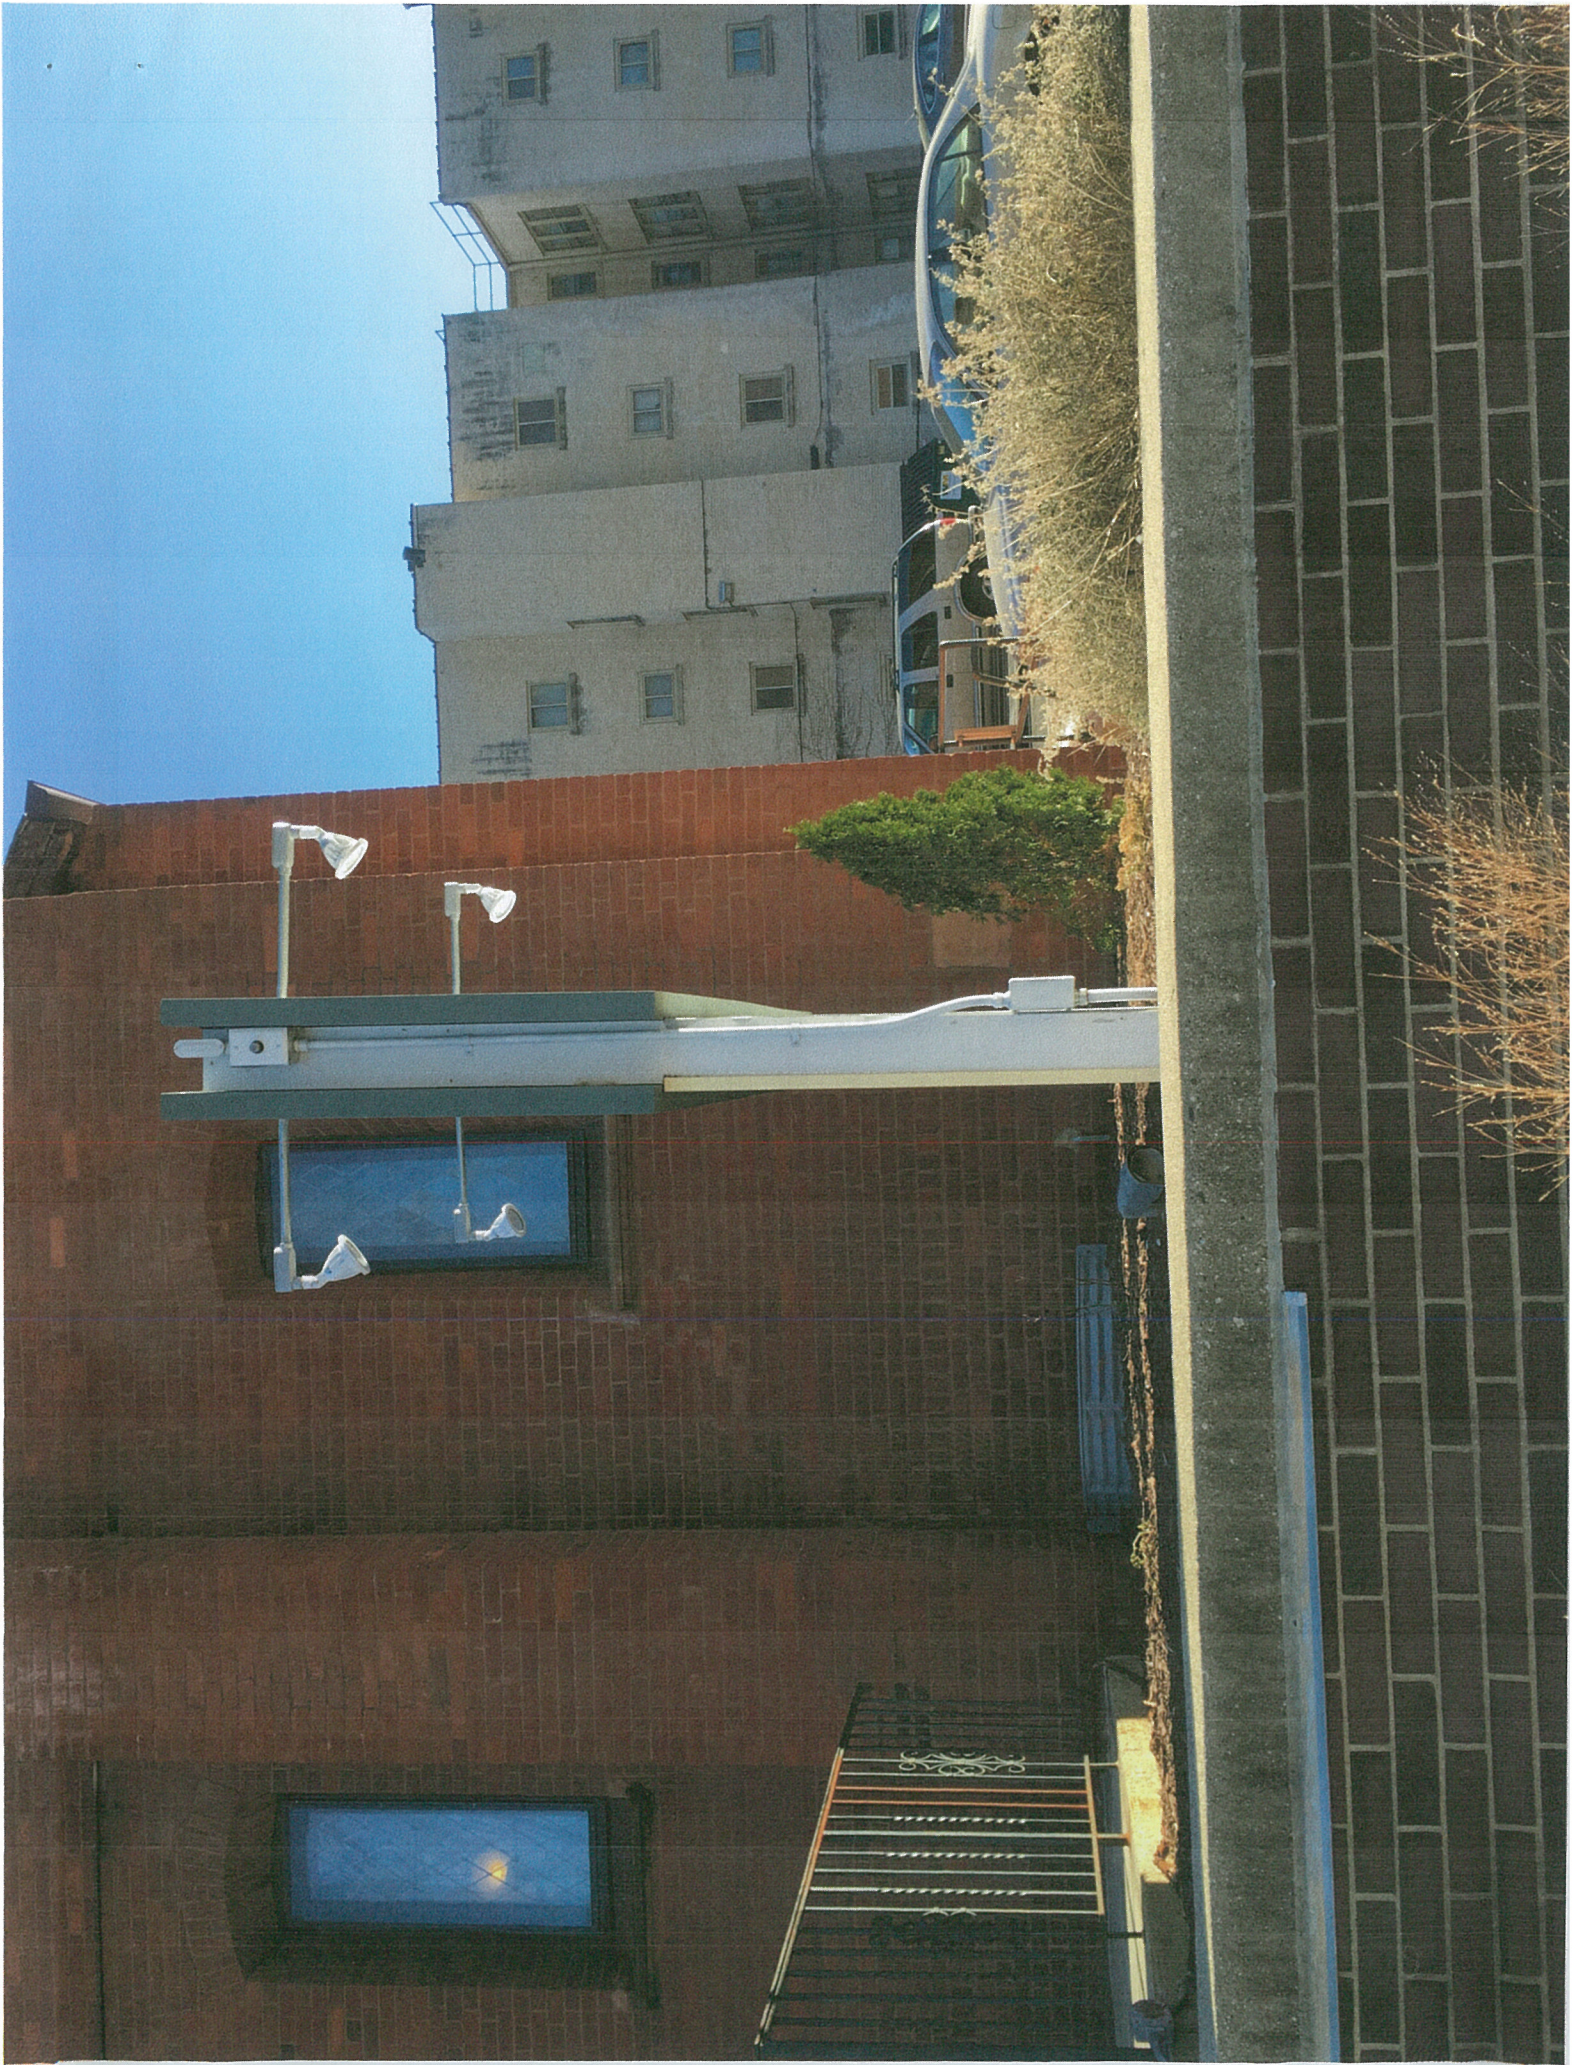

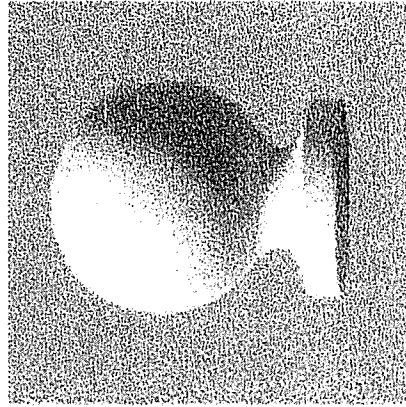

B4X6

Price:

\$41.24

CAD Elevation:

DWG DXF

CAD Profile:

DWG DXF

WIDTH

3.9710

HEIGHT

5.4110

LENGTH

0.0000

PROJECTION

0.0000

DIAMETER

0.0000

INSIDE DIAMETER

0.0000

RADIUS

0.0000

All dimensions in inches