



CCF 201416

Certificate of Appropriateness

Milwaukee Historic Preservation Commission/200 E. Wells Street/Milwaukee, WI 53202/phone 414-286-5712/fax 414-286-3004

Property 3360 N. SHERMAN BL.
Description of work Approved as submitted (with revised measurements). See attached. Brick base shall match brick on the school building as closely as practical in color and texture, while still using new modular brick.
Date issued 2/11/2021; Amended 8/3/2021 PTS
ID 115085 COA: monument sign

In accordance with the provisions of Section 320-21 (11) and (12) of the Milwaukee Code of Ordinances, the Milwaukee Historic Preservation Commission has issued a certificate of appropriateness for the work listed above. The work was found to be consistent with preservation guidelines. The following conditions apply to this certificate of appropriateness:

All work must be done in a craftsman-like manner, and must be completed within one year of the date this certificate was issued. Staff must approve any changes or additions to this certificate before work begins. Work that is not completed in accordance with this certificate may be subject to correction orders or citations. If you require technical assistance, please contact hpc@milwaukee.gov.

If permits are required, you are responsible for obtaining them from the Milwaukee Development Center. If you have questions about permit requirements, please consult the Development Center's web site, www.milwaukee.gov/build, or call (414) 286-8210.

City of Milwaukee Historic Preservation Staff



Copies to: Development Center, Ald. Rainey

TOWNSEND

3630 N SHERMAN BLVD

APPROVED

By Tim Askin - Milwaukee HPC at 2:45 pm, Aug 03, 2021

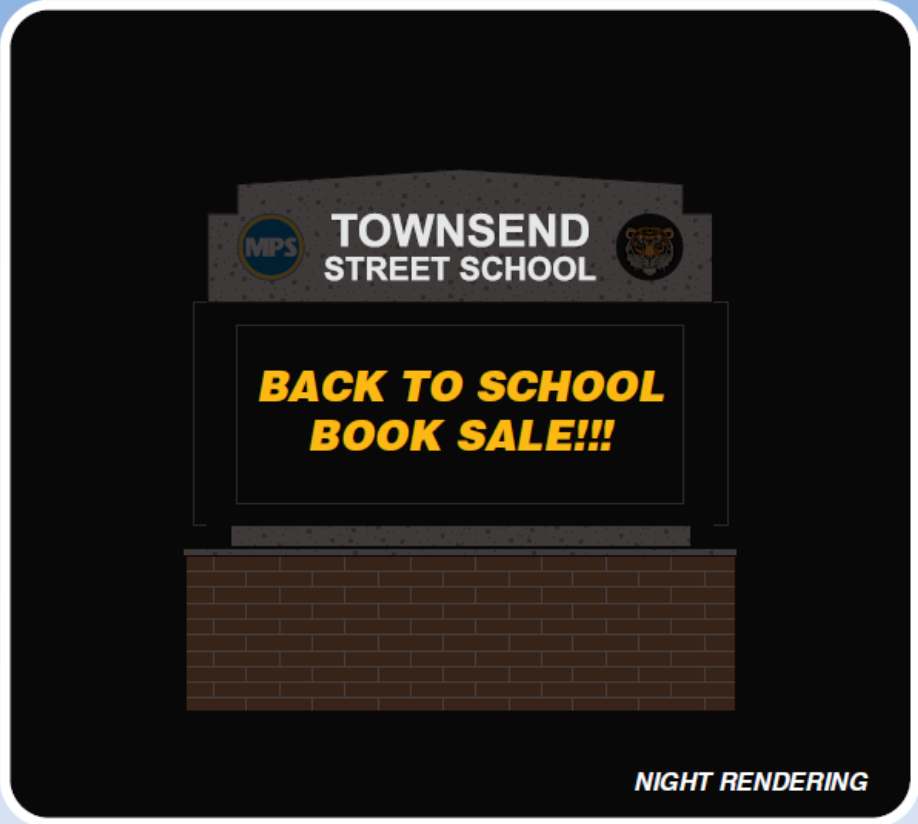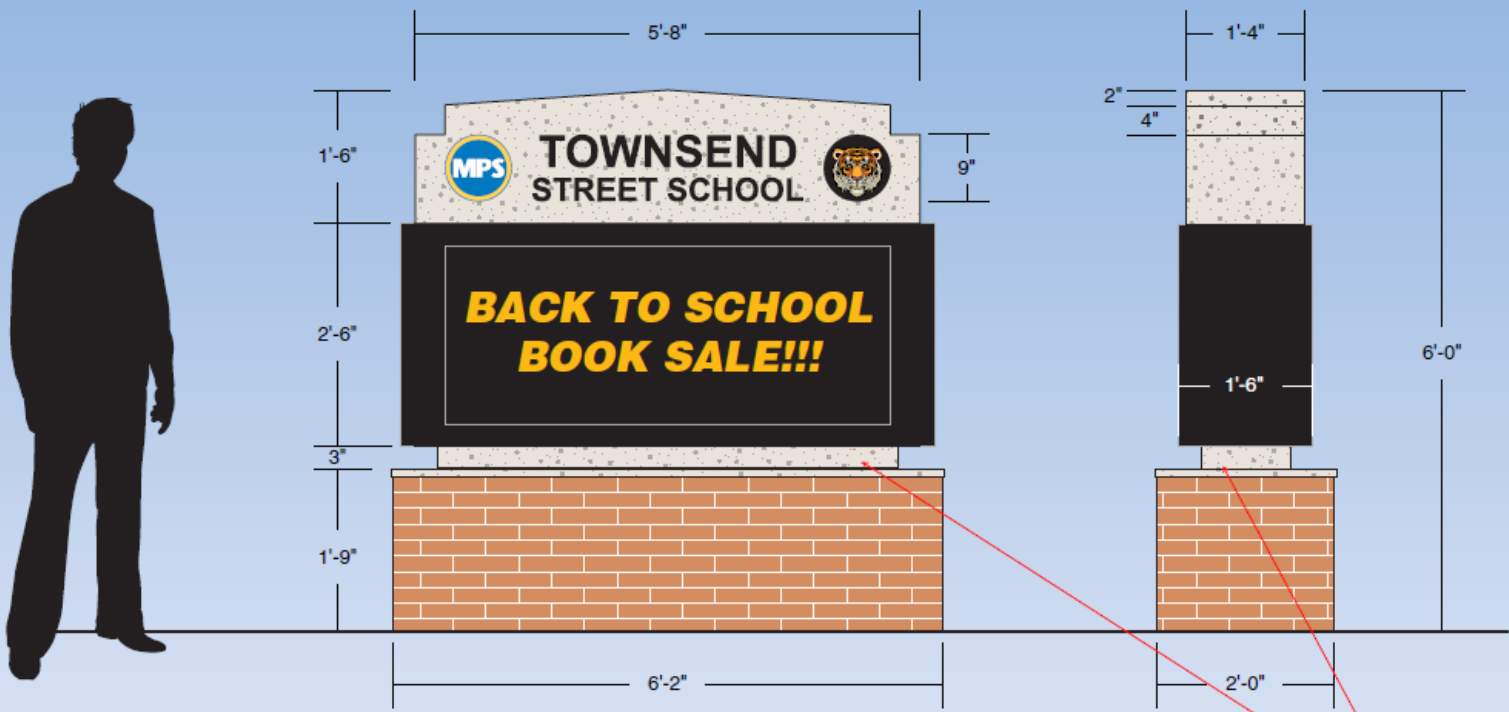

MPS / MONUMENT SIGN

ONE (1) DOUBLE SIDED, INTERNALLY ILLUMINATED MONUMENT SIGN
16" DEEP CUSTOM FABRICATED ALUMINUM CABINET W/ MAP TEXTURE PAINTED FINISH
ROUTED 1/8" ALUMINUM FACES BACKED W/ WHITE LEXAN
1/4" ALUMINUM MPS "PLAQUES" W/ DIGITALLY PRINTED VINYL GRAPHICS (NON-ILLUMINATED)
19MM WATCHFIRE AMBER LED DISPLAY (5'8"X2'6" - 32X80 MATRIX)
SIGN INTERNALLY ILLUMINATED W/ WHITE LEDS
MASONRY BASE BRICK & GROUT COLOR TO BE SELECTED FROM STANDARD FINISHES

SUBMIT PHYSICAL SAMPLE TO MPS PM FOR APPROVAL OF TEXTURE AND COLOR.

MPS MILWAUKEE PUBLIC SCHOOLS Department of Facilities & Maintenance Services
1124 N. 11th St., Milwaukee, WI 53233
(414) 283-4600 • mps.milwaukee.k12.wi.us

SHOP DRAWING/SUBMITTAL REVIEW

Review is only for general conformance with the design concept of the Contract Documents. Any comments or notations shall not be construed as relieving the Contractor from compliance with the Contract Documents, nor departure therefrom. The Contractor remains solely responsible for details and accuracy, for confirming and correlating all quantities and dimensions, for selecting fabrication processes, for techniques of assembly, for safety and for satisfactory performance of the Work.

☐ Reviewed Only ☐ Furnish as Submitted ☒ Furnish as Corrected
☐ Revise & Resubmit ☐ Rejected - See Comments Below

Reviewed By: *Maui Bethel* Date: 06/08/2021

COMMENTS: Submit paint samples and texture for MPS approval

 "We Project Your Image" PH: (262) 554-6066 TOLL FREE: (800) 554-8110	Client: MPS	Date: 5-17-21	REVISION		■ Illumination: <input type="checkbox"/> NO <input checked="" type="checkbox"/> YES TYPE LED	<input type="checkbox"/> SINGLE SIDED <input checked="" type="checkbox"/> DOUBLE SIDED	Paint Colors (AkzoNobel):	Vinyl Film Colors (3M Scotchcal):	Client Signature:
	Drawing #: 1(3)	Sheet: 1 of 1	1 5-26-21	△	Electrical Requirements: <input checked="" type="checkbox"/> 120 <input type="checkbox"/> 277	Quantity: 1	<input checked="" type="checkbox"/> MAP BLACK	<input type="checkbox"/> DIGITALLY PRINTED	Signature _____ Date _____
	Address: 3360 N SHERMAN BLVD	Scale: 1/2"=1'	2 6-1-21	△	Sign Specifications:		<input type="checkbox"/> MAP TEXTURE PAINTED FINISH	<input checked="" type="checkbox"/> 3M BLACK PERFORATED	NOTICE: Michael's Signs, Inc. does NOT provide primary electrical to sign location - RESPONSIBILITY OF OTHERS The ideas and designs contained in this original and unpublished drawing are the sole property of Michael's Signs, Inc. and MAY NOT BE USED OR REPRODUCED in whole or in part without written permission.
	City, State: MILWAUKEE, WI 53216	Designer: KD	3 6-2-21	△	NOTED ABOVE		<input type="checkbox"/> (TO RESEMBLE LIMESTONE)		
	Sales Rep: TONY MATALONIS		△	△					

NOTE: DUE TO THE PHYSICAL LIMITATIONS OF THE PAPER AND INK INVOLVED IN THIS PRINTING PROCESS, THIS CUSTOM ARTWORK IS NOT INTENDED TO PROVIDE AN EXACT MATCH TO THE ACTUAL FINISHED PAINTED PRODUCT.