


3630 N SHERMAN BLVD



ONE (1) DOUBLE SIDED, INTERNALLY ILLUMINATED MONUMENT SIGN
16" DEEP CUSTOM FABRICATED ALUMINUM CABINET W/ MAP TEXTURE PAINTED FINISH
ROUTED 1/8" ALUMINUM FACES BACKED W/ WHITE LEXAN
1/4" ALUMINUM MPS "PLAQUES" W/ DIGITALLY PRINTED VINYL GRAPHICS (NON-ILLUMINATED)
19MM WATCHFIRE AMBER LED DISPLAY (5'8"X2'6" - 32X80 MATRIX)
SIGN INTERNALLY ILLUMINATED W/ WHITE LEDS
MASONRY BASE BRICK & GROUT COLOR TO BE SELECTED FROM STANDARD FINISHES



**MILWAUKEE
PUBLIC SCHOOLS**

Department of Facilities & Maintenance Services
 1124 N. 11th St., Milwaukee, WI 53233
 (414) 283-4600 • mps.milwaukee.k12.wi.us

SHOP DRAWING/SUBMITTAL REVIEW

Review is only for general conformance with the design concept of the Contract Documents. Any comments or notations shall not be construed as relieving the Contractor from compliance with the Contract Documents, nor departure therefrom. The Contractor remains solely responsible for details and accuracy, for confirming and correlating all quantities and dimensions, for selecting fabrication processes, for techniques of assembly, for safety and for satisfactory performance of the Work.

☐ Reviewed Only

☐ Furnish as Submitted

☒ Furnish as Corrected

☐ Revise & Resubmit

☐ Rejected - See Comments Below

Reviewed By: *Maui Bethel*

Date: 06/08/2021



Michael's Signs


"We Project Your Image"







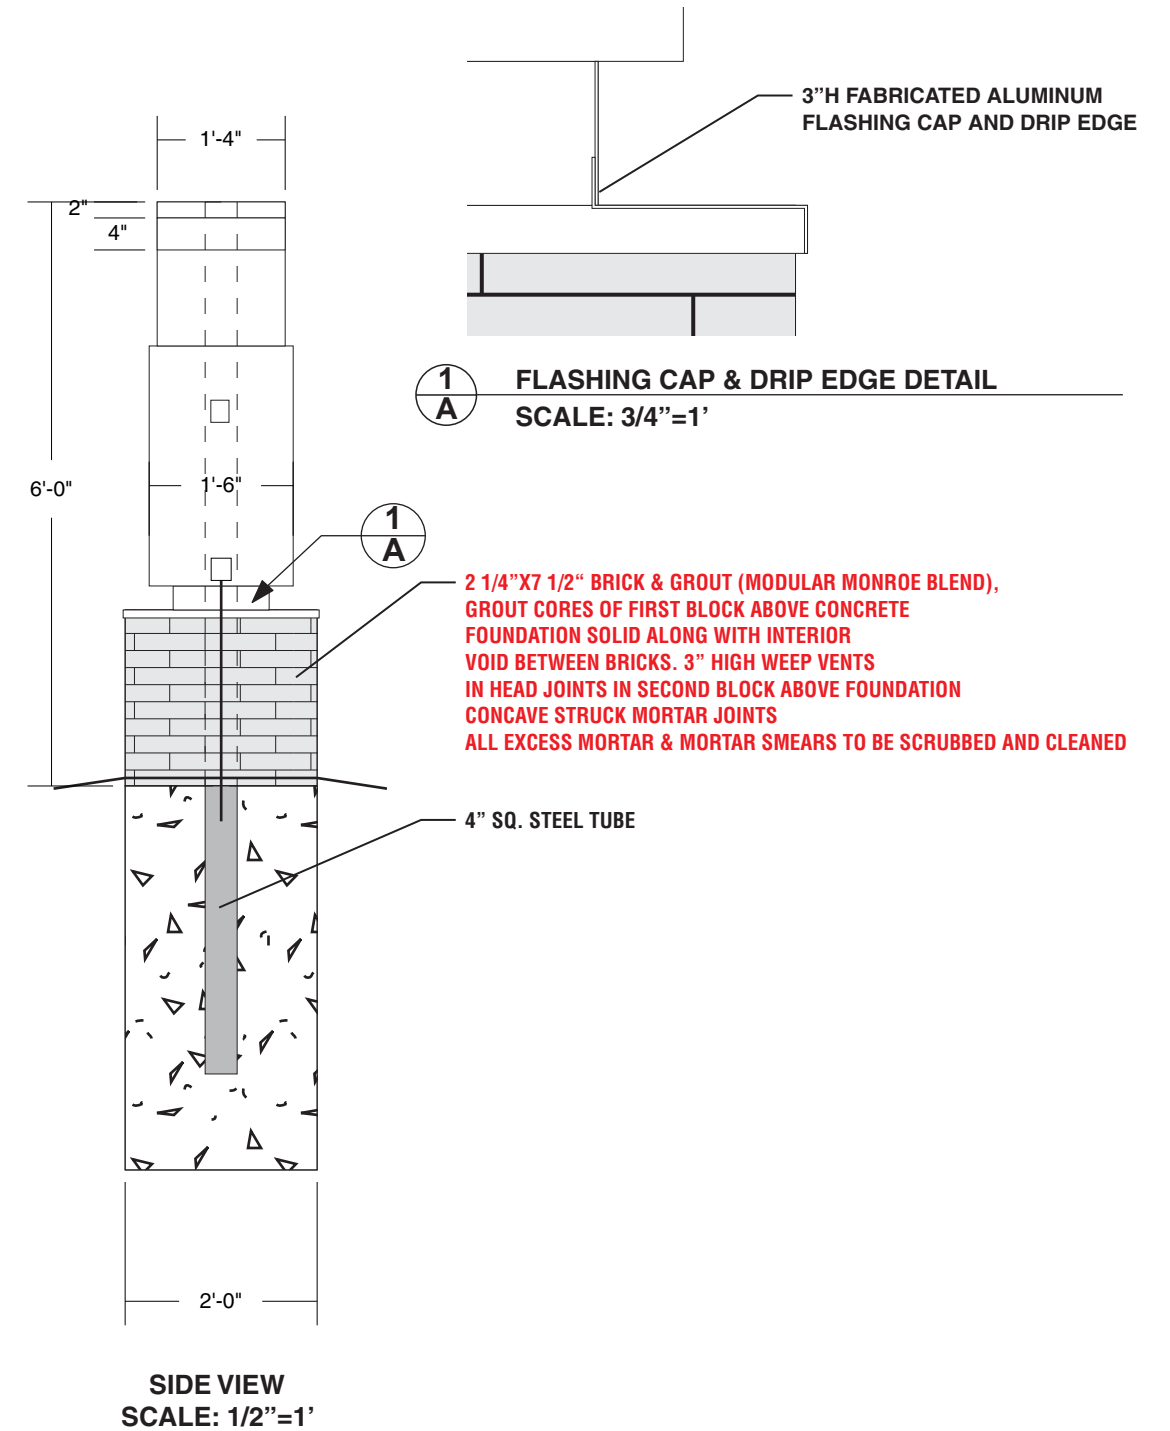


PH: (262) 554-6066
TOLL FREE: (800) 554-8110

Client: MPS	Date: 5-17-21	REVISION		Illumination: <input type="checkbox"/> NO <input checked="" type="checkbox"/> YES TYPE LED	<input type="checkbox"/> SINGLE SIDED <input checked="" type="checkbox"/> DOUBLE SIDED	Paint Colors (AkzoNobel): <input checked="" type="checkbox"/> MAP BLACK <input type="checkbox"/> MAP TEXTURE PAINTED FINISH <input type="checkbox"/> (TO RESEMBLE LIMESTONE)	Vinyl Film Colors (3M Scotchcal): <input type="checkbox"/> DIGITALLY PRINTED <input checked="" type="checkbox"/> 3M BLACK PERFORATED	Client Signature: _____ Signature _____ Date _____
	Drawing #: 1(3)	<input checked="" type="checkbox"/> 1 5-26-21 <input type="checkbox"/>	<input type="checkbox"/>	Electrical Requirements: <input checked="" type="checkbox"/> 120 <input type="checkbox"/> 277	Quantity: 1			NOTICE: Michael's Signs, Inc. does NOT provide primary electrical to sign location - RESPONSIBILITY OF OTHERS The ideas and designs contained in this original and unpublished drawing are the sole property of Michael's Signs, Inc. and MAY NOT BE USED OR REPRODUCED in whole or in part without written permission.
Address: 3360 N SHERMAN BLVD	Sheet: 1 of 1	<input checked="" type="checkbox"/> 2 6-1-21 <input type="checkbox"/>	<input type="checkbox"/>	Sign Specifications: NOTED ABOVE				
City, State: MILWAUKEE, WI 53216	Scale: 1/2" = 1'	<input checked="" type="checkbox"/> 3 6-2-21 <input type="checkbox"/>	<input type="checkbox"/>					
Sales Rep: TONY MATALONIS	Designer: KD	<input type="checkbox"/>	<input type="checkbox"/>					

NOTE: DUE TO THE PHYSICAL LIMITATIONS OF THE PAPER AND INK INVOLVED IN THIS PRINTING PROCESS, THIS CUSTOM ARTWORK IS NOT INTENDED TO PROVIDE AN EXACT MATCH TO THE ACTUAL FINISHED PAINTED PRODUCT.

3630 N SHERMAN BLVD



 <p><i>"We Project Your Image"</i></p> <p>PH: (262) 554-6066 TOLL FREE: (800) 554-8110</p>	Client: MPS	Date: 5-17-21	REVISION		Illumination: <input type="checkbox"/> NO <input checked="" type="checkbox"/> YES TYPE LED <input type="checkbox"/> SINGLE SIDED <input checked="" type="checkbox"/> DOUBLE SIDED	Paint Colors (AkzoNobel): <input checked="" type="checkbox"/> MAP BLACK <input checked="" type="checkbox"/> MAP DARK BRONZE <input type="checkbox"/> MAP TEXTURE PAINTED FINISH <input type="checkbox"/> (TO RESEMBLE LIMESTONE)	Vinyl Film Colors (3M Scotchcal): <input type="checkbox"/> DIGITALLY PRINTED <input checked="" type="checkbox"/> 3M BLACK PERFORATED	Client Signature: _____ Date _____ NOTICE: Michael's Signs, Inc. does NOT provide primary electrical to sign location - RESPONSIBILITY OF OTHERS The ideas and designs contained in this original and unpublished drawing are the sole property of Michael's Signs, Inc. and MAY NOT BE USED OR REPRODUCED in whole or in part without written permission.
		Drawing #: 1S(3)	 5-26-21 	Electrical Requirements: <input checked="" type="checkbox"/> 120 <input type="checkbox"/> 277	Quantity: 1			
	Address: 3360 N SHERMAN BLVD	Sheet: 1 of 1	 6-1-21 	Sign Specifications:				
	City, State: MILWAUKEE, WI 53216	Scale: 1/2"=1'	 6-2-21 	NOTED ABOVE				
	Sales Rep: TONY MATALONIS	Designer: KD	 					

NOTE: DUE TO THE PHYSICAL LIMITATIONS OF THE PAPER AND INK INVOLVED IN THIS PRINTING PROCESS, THIS CUSTOM ARTWORK IS NOT INTENDED TO PROVIDE AN EXACT MATCH TO THE ACTUAL FINISHED PAINTED PRODUCT.