ATTACHMENT #1
PAGE 1 OF 1

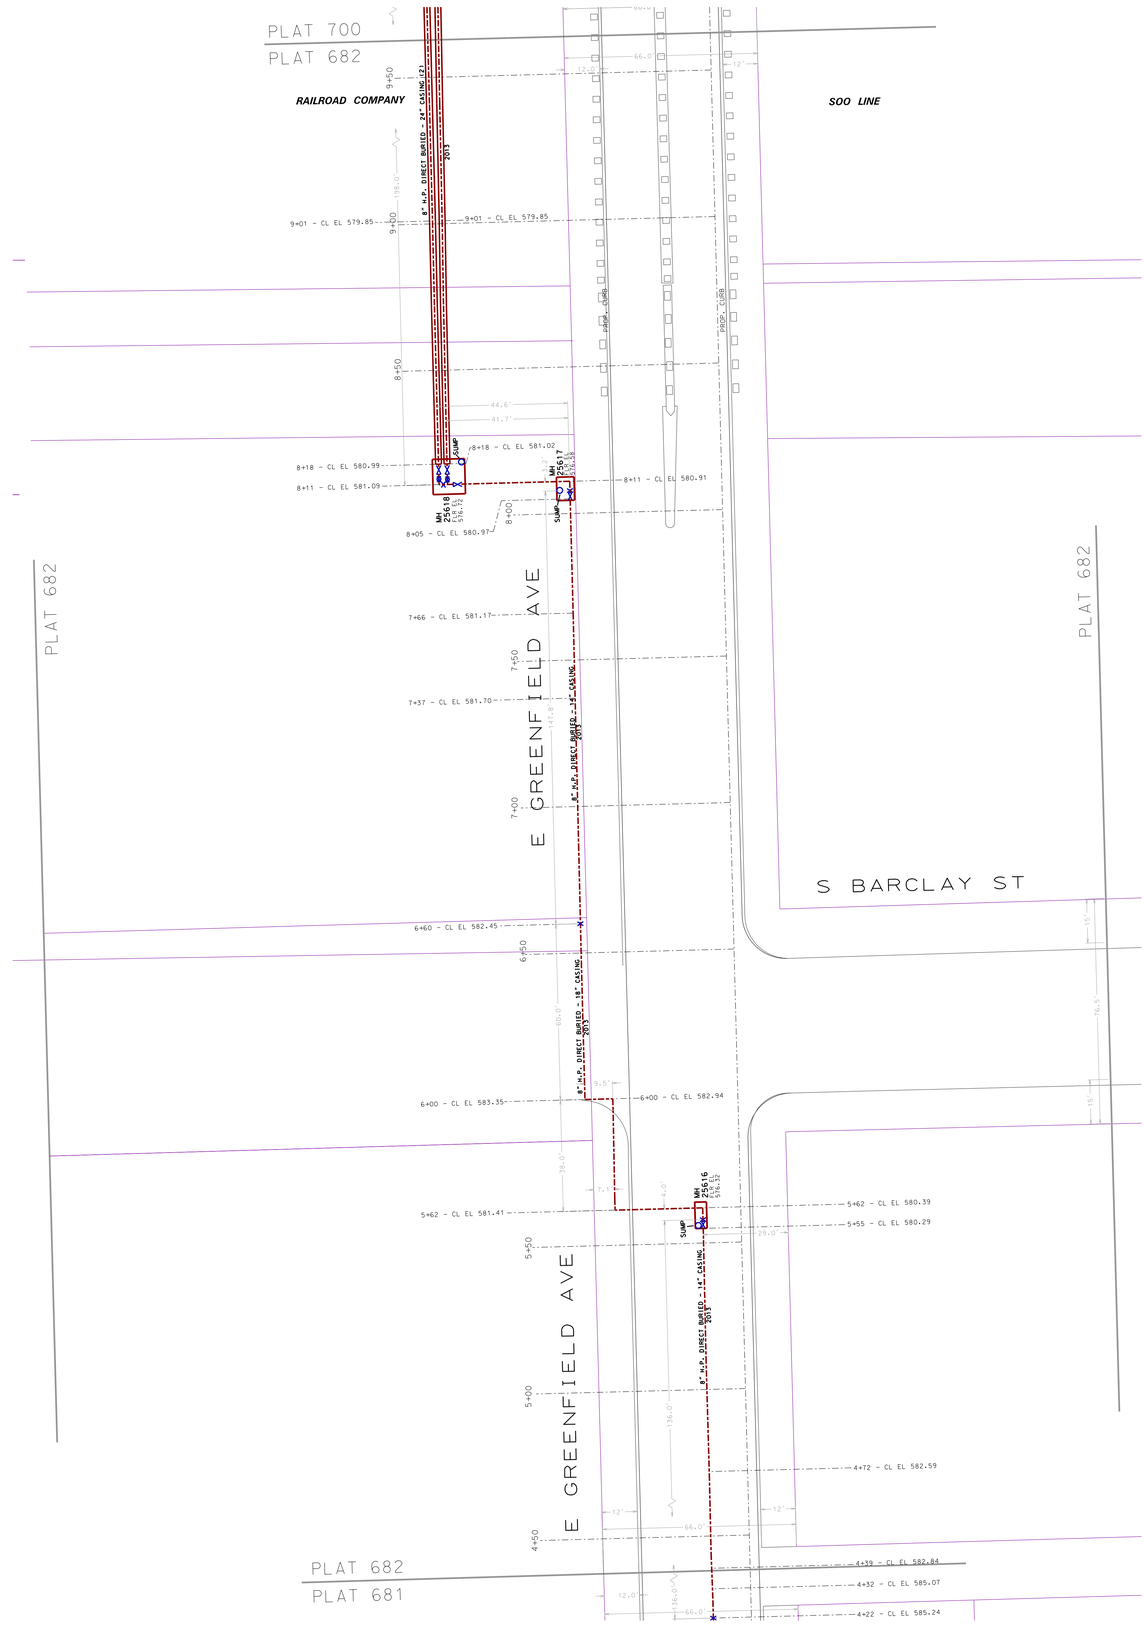

KEY

(STEAM SERVICES DISTRIBUTION)

- VALVE
- EXPANSION JOINT
- DOUBLE EXPANSION JOINT
- ANCHOR
- GUIDE
- REDUCER
- RISER
- SERVICE VALVE IN RISER
- BALL JOINT
- CROSSOVER
- SHAFT
- STEAM TUNNEL

RELATED DRAWINGS	FILE
MILWAUKEE MAP ONLINE LANDBASE INFORMATION	SSD MM Combo.dgn
MILWAUKEE UTILITIY INFORMATION - (DIGGERS)	SSD DIG Combo.dgn
DOWNTOWN LANDBASE INFORMATION - STEAM SERVICES	SSD WeGen BASE.dgn
DOWNTOWN STEAM SERVICES INFRASTRUCTURE INFORMATION	SSD WeGen Steam.dgn
DOWNTOWN TEMPORARY CONST. INFO. - STEAM SERVICES	SSD WeGen Construction.dgn
PLAT KEY MAP - DOWNTOWN	3069.dgn

SFILES

© WEP CO. THIS MAP IN WHOLE OR IN PART MAY NOT BE REPRODUCED IN ANY FORM OR BY ANY MEANS WITHOUT WRITTEN CONSENT OF THE WISCONSIN ELECTRIC POWER COMPANY

DIGGERS HOTLINE
WISCONSIN 1-800-242-8511
MILWAUKEE METRO 1-414-259-1181

FIELD TO VERIFY
ALL UNDERGROUND STRUCTURES AND UTILITIES HAVE BEEN SHOWN TO A REASONABLE DEGREE OF ACCURACY. IT IS THE CONTRACTOR'S RESPONSIBILITY TO VERIFY EXACT LOCATIONS

GENERAL LEGEND

LIGHT POLE
POWER POLE
MANHOLE
STORM INLET
CATCH BASIN
WATER VALVE
FIRE HYDRANT
ELECTRIC RISER
ELECTRIC MANHOLE
TELEPHONE MANHOLE
TRAFFIC SIGNAL
SIGN
GUARD POST
METAL POST
DRAIN TILE
GAS SERVICE VALVE
BUSH
DECIDUOUS TREE
CONIFEROUS TREE
FENCE LINE
TREE LINE
BURIED ELECTRIC LINE
BURIED FIBER OPTIC LINE
BURIED COMMUNICATIONS LINE
BURIED TELEPHONE LINE
BURIED GAS MAIN
BURIED WATER MAIN
BURIED CHILLED WATER LINE
BURIED STORM SEWER
BURIED SANITARY SEWER
OVERHEAD ELECTRIC LINE
BURIED TRAFFIC CONTROL

REV. NO.	DATE	INT. ORDER NO.	REVISION DESCRIPTION	WO.NO	DRAWN	CHKD.	APVD.
03	01-28-14	1008131	ADDED AS-BUILT INFO FOR NEW 8" HP SERVICE TO UWM	9403559	W39856	W41814	
02	04-30-13	1204244	PLAT UPDATE		W39856		
01	02-27-96		AS BUILT PER 1995 ADDED MANHOLE SECTION AND NOTE 5	6486	CRP	TPT	JJN

REVISION BLOCK

DOCUMENT NO. 689429
© We Energies
RELEASE DATE:
DRAWN | DATE | INT. ORDER NO.
CHECKED | DATE | WO.NO
APPROVED | DATE | SCALE 1" = 20'

We Energies
231 W. Michigan St
Milwaukee, WI 53203

FILE NAME: 689429.dgn

PLAT 682

CITY OF MILWAUKEE
STRUCTURAL PLAN
S BARKLAY & E GREENFIELD AVE.
PLAT 682
DOWNTOWN LAND BASE
STEAM SERVICES DIVISION

E	SSD	682	S	001	001	001	3

$DATES
$TIMES